

PANOVA
R38
11-23-71

MISSISSIPPI
 BOARD OF WATER COMMISSIONERS
 416 North State Street
 Jackson, Mississippi 39201

DEC 20 1971

WATER WELL DRILLERS LOG

CODED

NOV 23 1971
 date well completed

19 LIFE WELL CO.
 firm name

PANOVA
 county well located

LANDOWNER:	description of formations encountered	from	to
JAKE MCBRIDE	top soil	0	10
Courtland	white clay	10	15
(mailing address)	gravel	15	40
	clay	40	80
	sandy	80	183

WELL LOCATION:
 sec. 6 T. 9 N. R. 7 E.
 (S) (W)
2 miles E of Courtland
 (distance) (direction) (nearest town)

WELL PURPOSE: home
 (home, irrigation, municipal, industrial)


- WELL COMPLETION DATA:
- (1) diameter (inches) 4"
 - (2) total depth (feet) 193
 - (3) static water level (feet) 100 below above top of ground.
 - (4) casing PVC 183
 (material) (depth)
4"
 (size) If telescope see back.
 - (5) screen 10 183
 (length) (depth to top)
4" PVC scilica
 (size) (material)
 - (6) pump 3/4 10
 (HP) (yield gpm)
elec
 (type power)
 - (7) electric log no
 (yes or no)
 - (organization running log)
 - (8) how well bottom plugged Pvc cap

CODED

DRILLERS REMARKS:

If well telescopes please sketch and show depths.

GROUND LEVEL

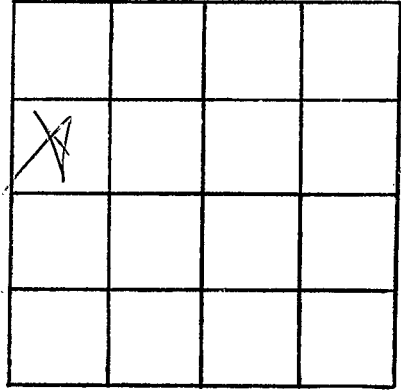

SECTION 6

Please indicate well location X.

ADDITIONAL INFORMATION

Lined area for additional information.

If more than one screen, show locations of each on sketch.