

PANOLA  
R 40  
8-5-71

MISSISSIPPI  
BOARD OF WATER COMMISSIONERS  
416 North State Street  
Jackson, Mississippi 39201

**CODED**

WATER WELL DRILLERS LOG

8-3- date well completed      1971 J.B. Cannon firm name      Panola county well located

LANDOWNER: Walker

description of formations encountered	from	to

(mailing address)

WELL LOCATION:  
sec. 21 T 9 N R 7 E  
7 miles S of Batesville  
(distance) (direction) (nearest town)

Clay	0	15
Water Sand	15	40

WELL PURPOSE: Irrigation  
(home, irrigation, municipal, industrial)

WELL COMPLETION DATA:

- (1) diameter (inches) 2"
- (2) total depth (feet) 40
- (3) static water level (feet) 25 below above top of ground.
- (4) casing Plastic, 40,  
(material) (depth)  
(size) if telescope see back.
- (5) screen 6, 34  
(length) (depth to top)  
2, Plastic  
(size) (material)
- (6) pump 110  
(HP) (yield gpm)  
Gasoline  
(type power)
- (7) electric log No  
(yes or no)

**CODED**

(organization running log)

(8) how well bottom plugged #2" Plug


MAY 25 1972

MISS. Bd. of  
WATER COMM.  
MEMBERS

DRILLERS REMARKS:

If well telescopes please sketch and show depths.

GROUND LEVEL

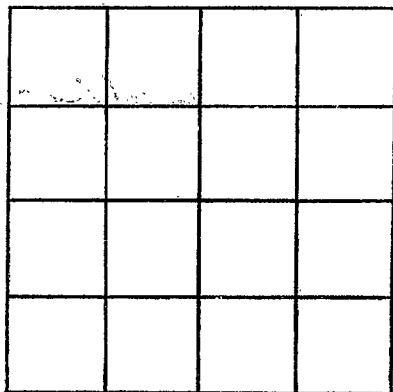

SECTION \_\_\_\_\_

Please indicate well location X.

ADDITIONAL INFORMATION

If more than one screen,  
show locations of each on sketch.