

PANOLA

R 41

10-23-72

MISSISSIPPI
 BOARD OF WATER COMMISSIONERS
 416 North State Street
 Jackson, Mississippi 39201

CODED

WATER WELL DRILLERS LOG

10-23
date well completed

1972 James R. Lipe
firm name

Panola
county well located

LANDOWNER: Mrs Grady

McCurdy

Batesville Miss.
(mailing address)

description of formations encountered

from

to

Clay

0

20

20

30

sand and clay
sand

30

40

40

46

WELL LOCATION:

sec. 26 T 9 N R 7 E
3 miles NE of Batesville
(distance) (direction) (nearest town)

WELL PURPOSE: HOME
(home, irrigation, municipal, industrial)

CODED

WELL COMPLETION DATA:

- (1) diameter (inches) 2
- (2) total depth (feet) 46
- (3) static water level (feet) 10 below top of ground.
- (4) casing PVC 40 (material) (depth)
2 (size) if telescope see back.
- (5) screen 6 40 (length) (depth to top)
2 PVC (size) (material)
- (6) pump 1/2 8 (HP) (yield gpm)
Elec. (type power)
- (7) electric log NO (yes or no)
NO (organization running log)
- (8) how well bottom plugged PVC plug


DRILLERS REMARKS:

PIVOT = 1 1/2 FT

MISS. BD. OF WATER COMMISSIONERS

If well telescopes please sketch and show depths.

GROUND LEVEL

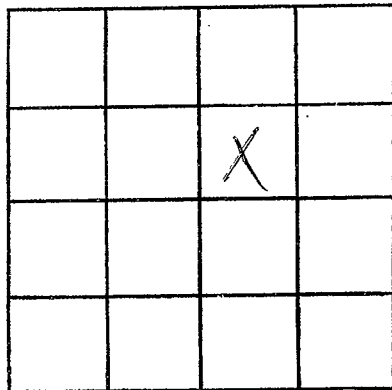

SECTION 26

Please indicate well location X.

ADDITIONAL INFORMATION

If more than one screen,
show locations of each on sketch.