

WELL DRILLERS LOG

PANOLA

Date: 1-7-61, 1961, Driller: J. P. Wiper County: Panola  
 (Name)

R 42

(1) Owner of Land: Edgar Daugherty  
 (Name)

Courtland, Miss  
 (Address)

(2) Location: 1/4, 1/4, Sec 33

3 miles No., of Courtland  
 (distance) (direction) (Nearest Town)

(3) Topography: (Hilly) (Flat) (Level)

(4) Purpose of Well: Domestic  
 (Domestic Irrigation, Municipal, Industrial, Other)

Information upon completion of well:

(1) Diameter 2 inches.

(2) Total Depth 136 feet.

(3) Water Level 70 feet below top of ground.

(4) Cased to 126, Size 2"

(5) Screen: Size 1 1/4, Length 6'

(6) Were any formations sealed against pollution?  
 \_\_\_\_\_ yes, \_\_\_\_\_ no.

If YES depth of formation \_\_\_\_\_

Why \_\_\_\_\_

Drillers Remarks: \_\_\_\_\_

Description & Color of Materials  
 Sand, Clay, Red Clay, Shales, etc.

**CODED**


Thick-ness Feet

Depth Feet

clay	0	20
clay	20	70
gravel	70	100
alluvial Sand	100	136

R

**CODED**

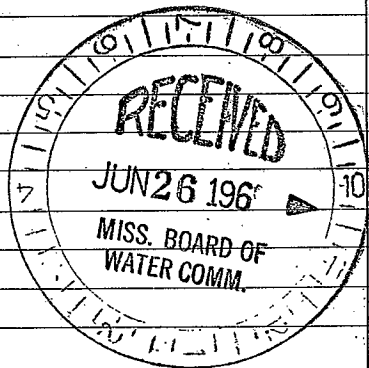

(Use Back Side)

Well No.

