

R43

WATER WELL DRILLERS LOG

CODED

12-12-61

Date: 12-12, 1961, Driller: J. B. Cain County Panola
(Name)

(1) Owner of Land: T. W. Beard
(Name)
COURTLAND MISS
(Address)

(2) Location: NW 1/4, Sec 33 T9S R7W
2 miles South of Batesville
(distance) (direction) (Nearest Town)

(3) Topography: (Hilly) (Flat) (Level)

(4) Purpose of Well: Home
(Domestic Irrigation
Municipal, Industrial, Other)

Description & Color of Materials Sand, Clay, Red Clay, Shell, etc.	Thick- ness Feet	Depth Feet
<u>Sand</u>	<u>0</u>	<u>60</u>
<u>slt</u>	<u>60</u>	<u>100</u>
<u>Sand</u>	<u>100</u>	<u>130</u>

Information upon completion of well:

(1) Diameter 4 inches.

(2) Total Depth 130 feet.

(3) Water Level 70 feet below top of ground.

(4) Cased to 130, Size 4"

(5) Screen: Size 4", Length 8 FT


(6) Were any formations sealed against pollution?
_____ yes, no.

If YES depth of formation _____

Why _____

Drillers Remarks: None

CODED

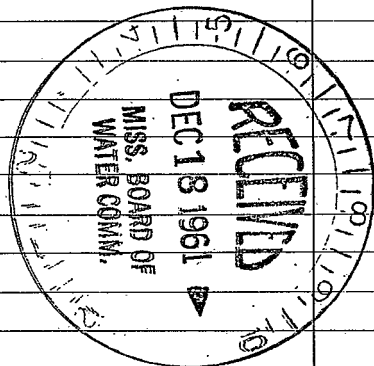

(Use Back Side)

Well No.

