

Date: **PANOLA**
3-14-61

Driller: **Joe R. Lipe** County **Denata**
(Name)

R46

(1) Owner of Land: **C. E. Gray**
(Name)

Batesville, Miss
(Address)

(2) Location: $\frac{1}{4}$, $\frac{1}{4}$, Sec. **27 T9 R7**
S W

4 miles **S.W.** of **Batesville**
(distance) (direction) (Nearest Town)

(3) Topography: **Hilly**
(Hilly) (Flat) (Level)

(4) Purpose of Well: **Domestic**
(Domestic Irrigation, Municipal, Industrial, Other)

Description & Color of Soil
Sand, Clay, Red Clay, Shell etc.

CODED

Depth Feet

Clay	0	5
ground	50	10
replenishing sand	100	13

Information upon completion of well:

(1) Diameter **2** inches.

(2) Total Depth **156** feet.

(3) Water Level **100** feet below top of ground.

(4) Cased to **130**, Size **2"**

(5) Screen: Size **1/4**, Length **6**

(6) Were there any formations sealed against pollution?

yes, no.


If YES depth of formation _____

Why _____

Drillers Remarks: _____

R

CODED

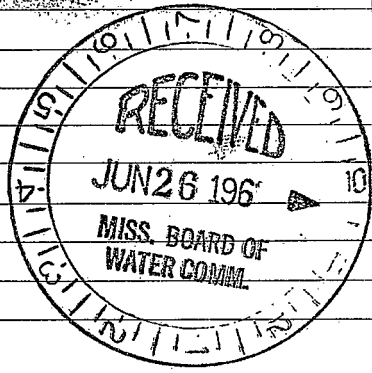

(Use Back Side)

Well No.:

1913

1913

1913