

MISSISSIPPI  
 BOARD OF WATER COMMISSIONERS  
 416 North State Street  
 Jackson, Mississippi 39201

**CODED**

WATER WELL DRILLERS LOG

Panola  
R 50  
2-67

2-15 1967 Robison & Son Panola  
 date well completed firm name county well located

LANDOWNER: J.S. Morris

description of formations encountered	from	to

RT 1

Batesville, Miss 38606  
 (mailing address)

<u>Red Clay</u>	<u>0</u>	<u>20</u>
<u>gravel &amp; sand</u>	<u>20</u>	<u>60</u>
<u>White Sand</u>	<u>60</u>	<u>70</u>

WELL LOCATION:


sec. 26 T. 9 N R. 7 E  
4 miles SE of Batesville  
 (distance) (direction) (nearest town)

WELL PURPOSE: Home  
 (home, irrigation, municipal, industrial)

WELL COMPLETION DATA:

- (1) diameter (inches) 4"
- (2) total depth (feet) 70
- (3) static water level (feet) 40 below above top of ground.
- (4) casing Plastic, 65  
 (material) (depth)  
4" if telescope see back.  
 (size)
- (5) screen 5 ft, 65 ft  
 (length) (depth to top)  
1/2 in, gravel packed  
 (size) (material)
- (6) pump 1/2 18  
 (HP) (yield gpm)  
220 V.P.A.  
 (type power)
- (7) electric log no  
 (yes or no)  
 (organization running log)
- (8) how well bottom plugged Wash  
bottom


**CODED**

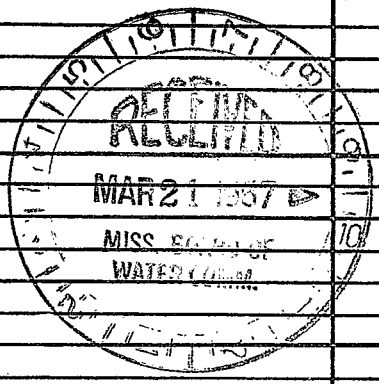

DRILLERS REMARKS: Plastic  
Water Well

If well telescopes please sketch and show depths.

GROUND LEVEL

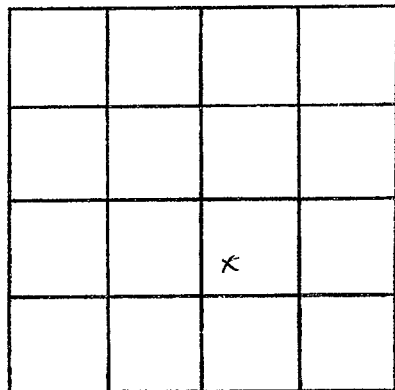

SECTION \_\_\_\_\_

Please indicate well location X.

ADDITIONAL INFORMATION

If more than one screen,  
show locations of each on sketch.