

Panola

R51

2-67

MISSISSIPPI
 BOARD OF WATER COMMISSIONERS
 416 North State Street
 Jackson, Mississippi 39201

CODED

WATER WELL DRILLERS LOG

2-24

date well completed

1967 Peterson & Son

firm name

Panola

county well located

LANDOWNER: Harry Sartin

description of formations encountered

from

to

Rt 1

Batesville, Miss 38606
(mailing address)

Red Clay
Gravel
Sand & Clay
Sand

0 20
20 100
100 140
140 160

WELL LOCATION:

sec. 20 T. 9 N R. 7 E
S W
3 miles S of Batesville
(distance) (direction) (nearest town)


WELL PURPOSE: Home
(home, irrigation, municipal, industrial)

WELL COMPLETION DATA:

- (1) diameter (inches) 4 in
- (2) total depth (feet) 160 ft
- (3) static water level (feet) 130 ft below top of ground.
- (4) casing Plastic, 155 ft
(material) (depth)
4 in if telescope see back.
(size)
- (5) screen 5 ft, 155 ft
(length) (depth to top)
6 in, Gravel packed
(size) (material)
- (6) pump 1/2, 12
(HP) (yield gpm)
220 V.A.
(type power)
- (7) electric log no
(yes or no)

(organization running log)
- (8) how well bottom plugged Wash
bottom


CODED

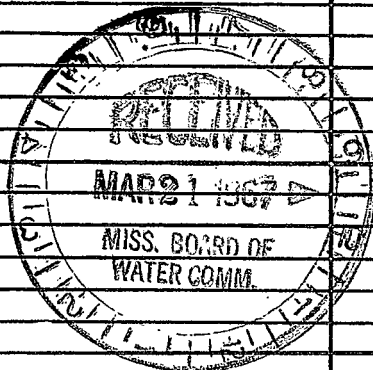

DRILLERS REMARKS: Plastic
Water well

If well telescopes please sketch and show depths.

GROUND LEVEL

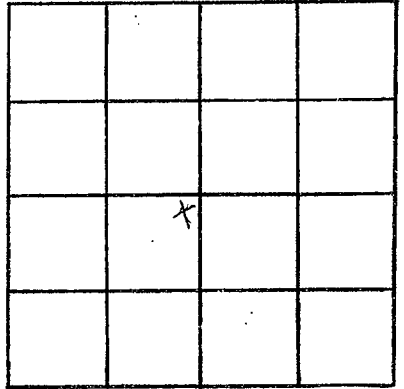

SECTION 30

Please indicate well location X.

ADDITIONAL INFORMATION

If more than one screen,
show locations of each on sketch.