

Panola
R52
5-67

MISSISSIPPI
BOARD OF WATER COMMISSIONERS
416 North State Street
Jackson, Mississippi 39201

CODED

WATER WELL DRILLERS LOG

5-2-3 1967 Roberson & Son Panola
date well completed firm name county well located

LANDOWNER: Mullins Joe, Co.
City - Court St.
Batesville, Miss
(mailing address)


description of formations encountered	from	to
<u>sand & clay</u>	<u>0</u>	<u>20</u>
<u>sand</u>	<u>20</u>	<u>60</u>
<u>clay</u>	<u>60</u>	<u>80</u>
<u>white sand</u>	<u>80</u>	<u>125</u>

WELL LOCATION:
sec. 8 T. 9 N. R. 7 E. W
miles of Batesville
(distance) (direction) (nearest town)

WELL PURPOSE: Industrial
(home, irrigation, municipal, industrial)

- WELL COMPLETION DATA:
- (1) diameter (inches) 4 in
 - (2) total depth (feet) 125
 - (3) static water level (feet) 18 below above top of ground.
 - (4) casing Plastic, 115,
(material) (depth)
4 in if telescope see back.
(size)
 - (5) screen 10 ft, 115
(length) (depth to top)
4 in, gravel packed
(size) (material)
 - (6) pump 1 1/2 HP, 60
(HP) (yield gpm)
VIA 220
(type power)
 - (7) electric log no
(yes or no)
YARD
(organization running log)
 - (8) how well bottom plugged Capped

CODED

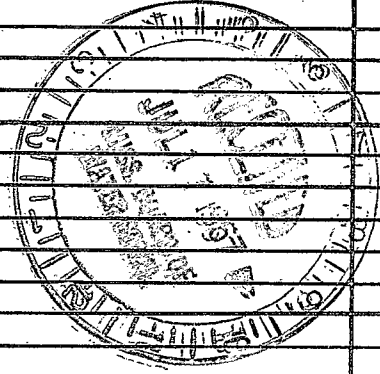

DRILLERS REMARKS: Plastic
Water

If well telescopes please sketch and show depths.

GROUND LEVEL

		X	

SECTION 8

Please indicate well location X.

ADDITIONAL INFORMATION

If more than one screen, show locations of each on sketch.