

Panola
R53
9-67

MISSISSIPPI
 BOARD OF WATER COMMISSIONERS
 416 North State Street
 Jackson, Mississippi 39201

CODED

WATER WELL DRILLERS LOG

9-7 19 *67* *Robertson* *Panola*
 date well completed firm name county well located

LANDOWNER: *Lincoln Bowser*
Coon Rd.
Bateville, Miss
 (mailing address)


description of formations encountered	from	to
<i>Sand + Clay</i>	<i>0</i>	<i>20</i>
<i>Sand</i>	<i>20</i>	<i>60</i>

WELL LOCATION:
 sec. *2* T. *9* N R. *7* E
4 miles *NE* of *Bateville*
 (distance) (direction) (nearest town)

WELL PURPOSE: *home*
 (home, irrigation, municipal, industrial)

- WELL COMPLETION DATA:
- (1) diameter (inches) *2"*
 - (2) total depth (feet) *60*
 - (3) static water level (feet) *18'* below above top of ground.
 - (4) casing *plastic*, *55'*,
 (material) (depth)
2" if telescope see back.
 (size)
 - (5) screen *55'*, *55'*
 (length) (depth to top)
3", *gravel*
 (size) (material)
 - (6) pump *None*
 (HP) (yield gpm)
 (type power)
 - (7) electric log *no*
 (yes or no)
 (organization running log)
 - (8) how well bottom plugged *Capped*

CODED

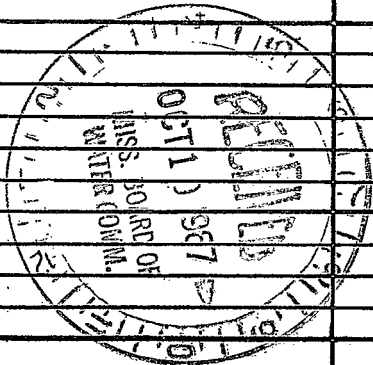

DRILLERS REMARKS: *Plastic*
Water well

If well telescopes please sketch and show depths.

GROUND LEVEL

		X	

SECTION 2

Please indicate well location X.

ADDITIONAL INFORMATION

If more than one screen, show locations of each on sketch.