

Panola
R 56
1-68

MISSISSIPPI
 BOARD OF WATER COMMISSIONERS
 416 North State Street
 Jackson, Mississippi 39201

CODED

WATER WELL DRILLERS LOG

Jan 31 19*68* *Roberson & Son* *Panola*
 date well completed firm name county well located

LANDOWNER: *Clarence Brewer*
Pl 1
Batesville, Miss
 (mailing address)

description of formations encountered	from	to
<i>Red Clay</i>	<i>0</i>	<i>20</i>
<i>White Clay & sand</i>	<i>20</i>	<i>40</i>
<i>White sand</i>	<i>40</i>	<i>60</i>


WELL LOCATION:
 sec. *1* T *9* N R *7* E
4 miles *S/E* of *Batesville*
 (distance) (direction) (nearest town)

WELL PURPOSE: *home*
 (home, irrigation, municipal, industrial)

WELL COMPLETION DATA:

- (1) diameter (inches) *4"*
- (2) total depth (feet) *60*
- (3) static water level (feet) *9* below top of ground.
- (4) casing *Plastic*, *55'*,
 (material) (depth)
4" if telescope see back.
 (size)
- (5) screen *5'*, *55'*
 (length) (depth to top)
6", *Gravel packed*
 (size) (material)
- (6) pump *2*, *60*
 (HP) (yield gpm)
220 VVA
 (type power)
- (7) electric log *no*
 (yes or no)
 (organization running log)
- (8) how well bottom plugged *plugged*


CODED

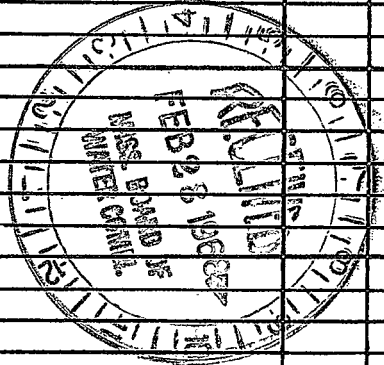

DRILLERS REMARKS: *Plastic*
Water well

If well telescopes please sketch and show depths.

GROUND LEVEL

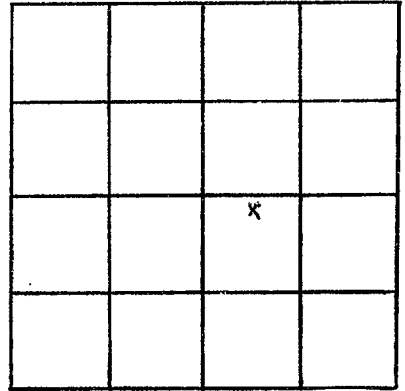

SECTION 1

Please indicate well location X.

ADDITIONAL INFORMATION

If more than one screen, show locations of each on sketch.