

MISSISSIPPI
BOARD OF WATER COMMISSIONERS
416 North State Street
Jackson, Mississippi 39201

WATER WELL DRILLERS LOG

CODED

PANOLA
R 57
3-68

Mar 27 1968 Robertson & Son Panola
date well completed firm name county well located

LANDOWNER: Tom Cooper

description of formations encountered

from to

St 2

Batesville, Miss.
(mailing address)

red clay	0	20
clay + sand	4.0	60
gravel + sand	60	80
sand	80	96

WELL LOCATION:

sec. 35 T 8 N R 3 E
S W
4 miles SE of B. Mill.
(distance) (direction) (nearest town)

WELL PURPOSE: home
(home, irrigation, municipal, industrial)

WELL COMPLETION DATA:

- (1) diameter (inches) 2"
- (2) total depth (feet) 96
- (3) static water level (feet) 50 below top of ground.
- (4) casing stck. 90
(material) (depth)
2 1/2 if telescope see back.
(size)
- (5) screen 6 ft 90
(length) (depth to top)
1 1/2 brass
(size) (material)
- (6) pump 1/2 5
(HP) (yield gpm)
TVA 110
(type power)
- (7) electric log no
(yes or no)

(organization running log)
- (8) how well bottom plugged plugged


CODED

MAY 1 1968
MISS. BD. OF
WATER COMMISSIONERS

DRILLERS REMARKS: stck well

If well telescopes please sketch and show depths.

GROUND LEVEL

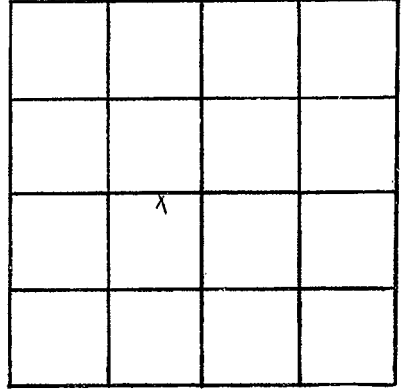

SECTION 35

Please indicate well location X.

ADDITIONAL INFORMATION

If more than one screen, show locations of each on sketch.