

Panola  
R 58,  
9-5-68

MISSISSIPPI  
 BOARD OF WATER COMMISSIONERS  
 416 North State Street  
 Jackson, Mississippi 39201

WATER WELL DRILLERS LOG


Sept 5 1968 Robison & Son Panola  
 date well completed firm name county well located

LANDOWNER: Byron Brewer  
Bateville, Miss  
 (mailing address)  
 WELL LOCATION:  
 sec. 2 T. 9 N. R. 7 E.  
4 miles NE of Bateville  
 (distance) (direction) (nearest town)

description of formations encountered	from	to
<u>Red Clay</u>	<u>0</u>	<u>20</u>
<u>Gravel &amp; sand</u>	<u>20</u>	<u>40</u>
<u>White sand</u>	<u>40</u>	<u>60</u>

WELL PURPOSE:  
 (home, irrigation, municipal, industrial)


- WELL COMPLETION DATA:
- (1) diameter (inches) 4"
  - (2) total depth (feet) 60
  - (3) static water level (feet) 5 below top of ground.
  - (4) casing plastic, 55  
 (material) (depth)  
4" if telescope see back.  
 (size)
  - (5) screen 5 ft, 55  
 (length) (depth to top)  
4, gravel packed  
 (size) (material)
  - (6) pump 1/2, 8  
 (HP) (yield gpm)  
2VA 3.20  
 (type power)
  - (7) electric log yes  
 (yes or no)  
 (organization running log)
  - (8) how well bottom plugged Capped

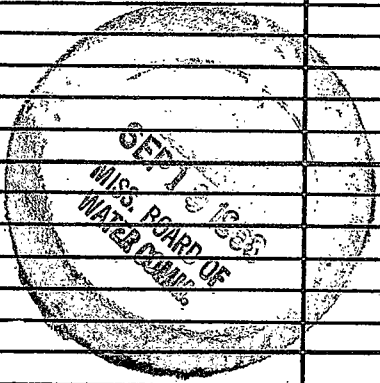

DRILLERS REMARKS: Plastic water well

If well telescopes please sketch and show depths.

GROUND LEVEL

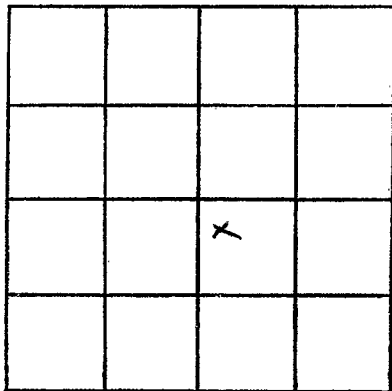

SECTION 2

Please indicate well location X.

ADDITIONAL INFORMATION

If more than one screen,  
show locations of each on sketch.