

Panola  
R 60  
8-20-73

MISSISSIPPI  
 BOARD OF WATER COMMISSIONERS  
 416 North State Street  
 Jackson, Mississippi 39201

**CODED**

WATER WELL DRILLERS LOG

8-20 1973 JAMES R. LIPE Panola  
 date well completed firm name county well located

LANDOWNER:  
Ben Green  
Courtland Miss,  
 (mailing address)

| description of formations encountered | from | to  |
|---------------------------------------|------|-----|
| Top soil                              | 0    | 20  |
| Clay                                  | 20   | 40  |
| sand                                  | 40   | 60  |
| sand and gravel                       | 60   | 80  |
| gravel                                | 80   | 100 |
| "                                     | 100  | 120 |
| sand                                  | 120  | 154 |

WELL LOCATION:  
 sec 21 T 8 N R 7 E  
3 miles north of Courtland  
 (distance) (direction) (nearest town)

WELL PURPOSE:  
 (home irrigation, municipal, industrial)

**CODED**

WELL COMPLETION DATA:

(1) diameter (inches) 4

(2) total depth (feet) 154

(3) static water level (feet) 140 below top of ground.

(4) casing PVC, 144  
 (material) (depth)  
4 if telescope see back.  
 (size)

(5) screen 10, 144  
 (length) (depth to top)  
4, PVC  
 (size) (material)

(6) pump 3/4, 10  
 (HP) (yield gpm)  
elec  
 (type power)

(7) electric log no  
 (yes or no)  
no  
 (organization running log)

(8) how well bottom plugged PVC  
plug


DRILLERS REMARKS:

SEP 6 1973

MISSISSIPPI  
 WATER

If well telescopes please sketch and show depths.

GROUND LEVEL

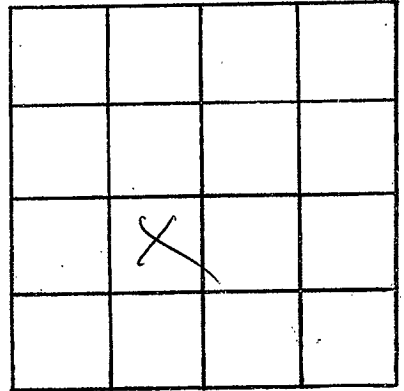

SECTION 21

Please indicate well location X.

ADDITIONAL INFORMATION

If more than one screen,  
show locations of each on sketch.