

**PANOLA**  
**R62**  
**11-16-73**

MISSISSIPPI  
 BOARD OF WATER COMMISSIONERS  
 416 North State Street  
 Jackson, Mississippi 39201

WATER WELL DRILLERS LOG

**CODED**

11-16

1973 Lipe well Co.

Panola

date well completed

firm name

county well located

LANDOWNER:  
 seab woodruff  
 Courtland Miss.  
 (mailing address)

description of formations encountered	from	to
Clay	0	20
"	20	40
Gravel	40	60
Sand	60	80
"	80	109

WELL LOCATION:  
 sec. 36 T 9 N R 7 E  
 4 miles East of Courtland  
 (distance) (direction) (nearest town)

WELL PURPOSE:  
 (home, irrigation, municipal, industrial)

- WELL COMPLETION DATA:
- (1) diameter (inches) 4
  - (2) total depth (feet) 102
  - (3) static water level (feet) 90 below top of ground.
  - (4) casing PVC, 92  
 (material) (depth)  
4 If telescope see back.  
 (size)
  - (5) screen 10, 92  
 (length) (depth to top)  
4, PVC  
 (size) (material)
  - (6) pump 3/4, 8  
 (HP) (yield gpm)  
elec.  
 (type power)
  - (7) electric log no  
 (yes or no)  
no  
 (organization running log)
  - (8) how well bottom plugged PVC  
P/UG


**CODED**

DEC 1 1973

DRILLERS REMARKS:

If well telescopes please sketch and show depths.

GROUND LEVEL

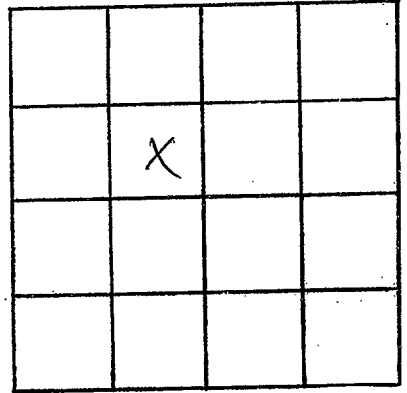

SECTION 36

Please indicate well location X.

ADDITIONAL INFORMATION

If more than one screen,  
show locations of each on sketch.