

PANOLA  
R 64  
2-13-74

MISSISSIPPI  
BOARD OF WATER COMMISSIONERS  
416 North State Street  
Jackson, Mississippi 39201

CODED

WATER WELL DRILLERS LOG

2-13 date well completed  
1974 Lipe Well Co firm name  
Panola county well located

LANDOWNER:	description of formations encountered	from	to
Federal Compress	TOP Soil	0	20
Batesville Miss.	Clay	20	40
(mailing address)	sand	40	60
		60	115

WELL LOCATION:  
sec. 12 T 9 N R 7 E  
1/2 miles S.W. of Batesville  
(distance) (direction) (nearest town)

WELL PURPOSE:  
(home, irrigation, municipal, industrial)

- WELL COMPLETION DATA:
- (1) diameter (inches) 4
  - (2) total depth (feet) 115
  - (3) static water level (feet) 20 below top of ground.
  - (4) casing PVC 100 (material) (depth)
  - 4 (size) if telescope see back.
  - (5) screen 15 100 (length) (depth to top)
  - 4 PVC (size) (material)
  - (6) pump 5 20 (HP) (yield gpm)
  - elec. (type power)
  - (7) electric log no (yes or no)
  - no (organization running log)
  - (8) how well bottom plugged PVC PLUS

CODED




MAR - 5 1974

DRILLERS REMARKS:

MISS. BD. OF WATER COMM.

If well telescopes please sketch and show depths.

GROUND LEVEL

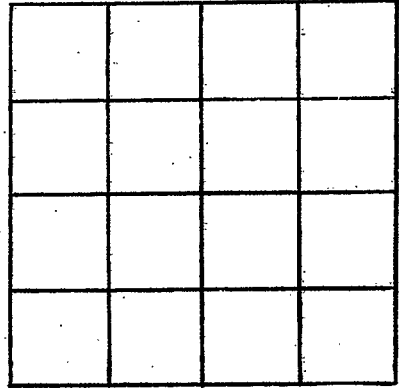

SECTION \_\_\_\_\_

Please indicate well location X.

ADDITIONAL INFORMATION

If more than one screen, show locations of each on sketch.