

PANOLA  
R 65  
3-15-74

MISSISSIPPI  
BOARD OF WATER COMMISSIONERS  
416 North State Street  
Jackson, Mississippi 39201

CODED

WATER WELL DRILLERS LOG

3-15 date well completed  
1974 Life Well Co. firm name  
Panola county well located

LANDOWNER:	description of formations encountered	from	to
Morvy Brasell Batesville Miss. (mailing address)			
	SAND	20	40
	''	42	60
	''	60	80
	''	80	90

WELL LOCATION:  
sec 17 T 9 N R 37 W  
1/2 miles south of Batesville  
(distance) (direction) (nearest town)

WELL PURPOSE:  
(home, irrigation, municipal, industrial)

WELL COMPLETION DATA:


- (1) diameter (inches) 4"
- (2) total depth (feet) 90
- (3) static water level (feet) 10 below top of ground.
- (4) casing PVC 80 (material) (depth)  
4 (size) If telescope see back.
- (5) screen 10 80 (length) (depth to top)  
4 PVC (size) (material)
- (6) pump 3/4 10 (HP) (yield gpm)  
elec (type power)
- (7) electric log no (yes or no)  
no (organization running log)
- (8) how well bottom plugged PVC Plug

CODED

DRILLERS REMARKS:  
APR - 3 1974

If well telescopes please sketch and show depths.

GROUND LEVEL

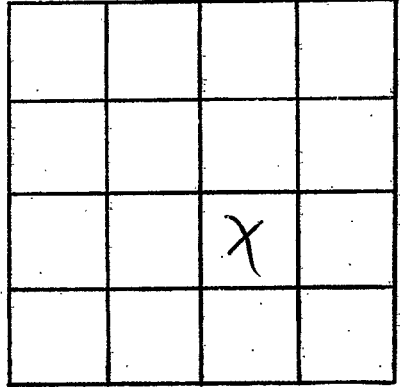

SECTION 17

Please indicate well location X.

ADDITIONAL INFORMATION

If more than one screen, show locations of each on sketch.