

PANOLA
R 66
4-29-74

MISSISSIPPI
BOARD OF WATER COMMISSIONERS
416 North State Street
Jackson, Mississippi 39201

CODED

WATER WELL DRILLERS LOG

4-29 date well completed
1974 Lipe Well Co firm name
Panola county well located

LANDOWNER:
Chloris Reed
Batesville Miss.
(mailing address)

description of formations encountered	from	to
Top soil	0	20
clay	20	40
gravel	40	60
ll	60	80
sand	80	100
white sand	100	162

WELL LOCATION:
sec. 27 T 9 N R 7 E
5 miles S. E. of Batesville
(distance) (direction) (nearest town)

WELL PURPOSE:
(home, irrigation, municipal, industrial)

- WELL COMPLETION DATA:
- (1) diameter (inches) 4
 - (2) total depth (feet) 162
 - (3) static water level (feet) 102 below top of ground.
 - (4) casing PVC 152 (material) (depth)
 - 4 If telescope see back. (size)
 - (5) screen 10 152 (length) (depth to top)
 - 4 PVC (size) (material)
 - (6) pump 3/4 10 (HP) (yield gpm)
 - elec. (type power)
 - (7) electric log NO (yes or no)
 - NO (organization running log)
 - (8) how well bottom plugged PVC PLUG


CODED

RECEIVED
MAY 20 1974
MISS. BD. OF WATER COMMISSIONERS

DRILLERS REMARKS:

If well telescopes please sketch and show depths.

GROUND LEVEL

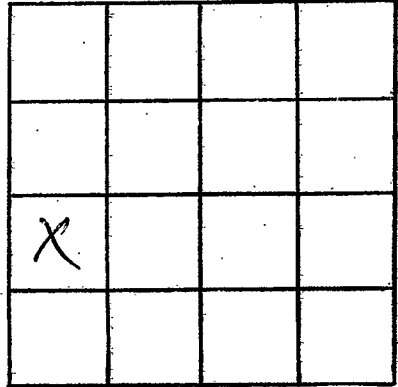

SECTION 27

Please indicate well location X.

ADDITIONAL INFORMATION

If more than one screen,
show locations of each on sketch.