

Big Stream Well Drilling Co -

PANOLA  
R 67  
3-5-74

MISSISSIPPI  
BOARD OF WATER COMMISSIONERS CODED  
416 North State Street  
Jackson, Mississippi 39201

WATER WELL DRILLERS LOG

March 5 1974 of B. Cain PANOLA  
date well completed firm name county well located

LANDOWNER: Mr. Trotter

description of formations encountered from to

(mailing address)

Brown clay sand 0 90

WELL LOCATION:

sec. 12 T 9 N R 7 E  
4 miles E of Bataulke  
(distance) (direction) (nearest town)

Gravel 90 130

Rock 135 139

WELL PURPOSE: None  
(home, irrigation, municipal, industrial)

Blue Clay 138 175

WELL COMPLETION DATA:

(1) diameter (inches) 4"  
(2) total depth (feet) 199  
(3) static water level (feet) 75 below above top of ground.

Sand 175 199

(4) casing Plastic 199  
(material) (depth)

(5) screen 10' 187  
4" (length) (depth to top)  
Plastic  
(size) (material)


(6) pump 3/4 10  
(HP) (yield gpm)  
Elec  
(type power)

(7) electric log 50  
(yes or no)

(organization running log)

(8) how well bottom plugged Plug


DRILLERS REMARKS:

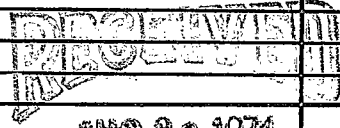

MAR 20 1974

If well telescopes please sketch and show depths.

GROUND LEVEL

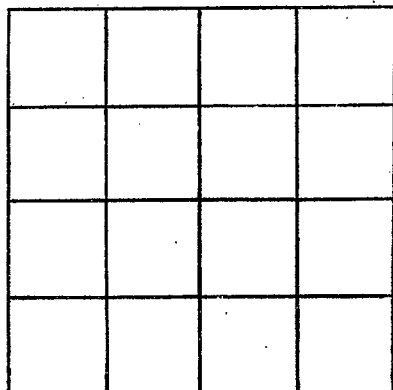

SECTION \_\_\_\_\_

Please indicate well location X.

ADDITIONAL INFORMATION

If more than one screen,  
show locations of each on sketch.