

Panola  
R 68  
8-18-74

MISSISSIPPI  
BOARD OF WATER COMMISSIONERS  
416 North State Street  
Jackson, Mississippi 39201 CODED

WATER WELL DRILLERS LOG


8-18-1974 W.A. Mason Panola  
date well completed firm name county well located

LANDOWNER:  
Kyle Jaslin  
Baleville Miss.  
(mailing address)

WELL LOCATION:  
sec. 15 T. 9 N. R. 7 E.  
1/2 miles East of Baleville  
(distance) (direction) (nearest town)

WELL PURPOSE: domestic  
(home, irrigation, municipal, industrial)


- WELL COMPLETION DATA:
- (1) diameter (inches) 4
  - (2) total depth (feet) 156'
  - (3) static water level (feet) 93' below top of ground.
  - (4) casing Plastic 146'  
(material) (depth)
  - 4" If telescope see back.  
(size)
  - (5) screen 10' 146'  
(length) (depth to top)
  - 4" Plastic  
(size) (material)
  - (6) pump 3/4 10  
(HP) (yield gpm)
  - electric  
(type power)
  - (7) electric log No  
(yes or no)
  - (organization running log)
  - (8) how well bottom plugged Cap

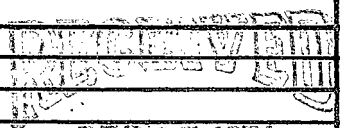description of formations encountered	from	to
Clay loam	70	15
Red sand	15	80
gravel	80	110
white sand	110	156
CODED		
 DEC 27 1974		
MISS. BD. OF WATER COMMISSIONERS		

DRILLERS REMARKS:

If well telescopes please sketch and show depths.

GROUND LEVEL

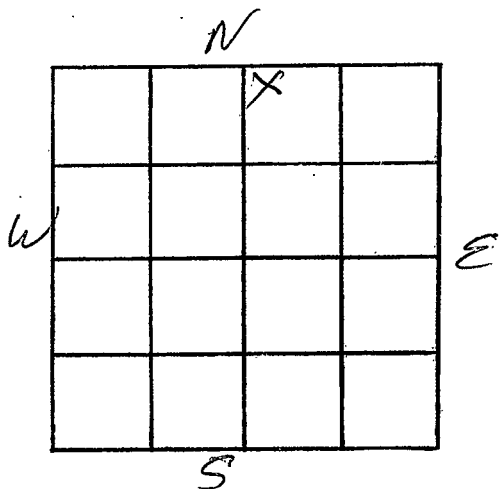

SECTION 15

Please indicate well location X.

ADDITIONAL INFORMATION

If more than one screen, show locations of each on sketch.