

Panola  
R 69  
12-6-74

MISSISSIPPI  
 BOARD OF WATER COMMISSIONERS  
 416 North State Street  
 Jackson, Mississippi 39201

WATER WELL DRILLERS LOG

CODED

12-6  
 date well completed

1974 Lipe well Co.  
 firm name

Panola  
 county well located

LANDOWNER:  
Joe Chapman  
Batesville Miss.  
 (mailing address)

description of formations encountered	from to	
	feet	feet
<u>Top soil</u>	<u>0</u>	<u>20</u>
<u>Gravel</u>	<u>20</u>	<u>40</u>
<u>ll</u>	<u>40</u>	<u>60</u>
<u>sand</u>	<u>60</u>	<u>80</u>
<u>ll</u>	<u>80</u>	<u>127</u>

WELL LOCATION:  
 sec 27 T 18 N R 7 E  
3 miles east of Batesville  
 (distance) (direction) (nearest town)

WELL PURPOSE:  
 (home, irrigation, municipal, industrial)

- WELL COMPLETION DATA:
- (1) diameter (inches) 4
  - (2) total depth (feet) 127
  - (3) static water level (feet) 90 below top of ground.
  - (4) casing PVC 117  
 (material) (depth)  
4 if telescope see back.  
 (size)
  - (5) screen 10 117  
 (length) (depth to top)  
4 PVC  
 (size) (material)
  - (6) pump 3/4 10  
 (HP) (yield gpm)  
elec  
 (type power)
  - (7) electric log no  
 (yes or no)  
no  
 (organization running log)
  - (8) how well bottom plugged PVC Plug

CODED

RECEIVED


DEC 31 1974

DRILLERS REMARKS:

MISS. BD. OF WATER COMM

If well telescopes please sketch and show depths.

GROUND LEVEL

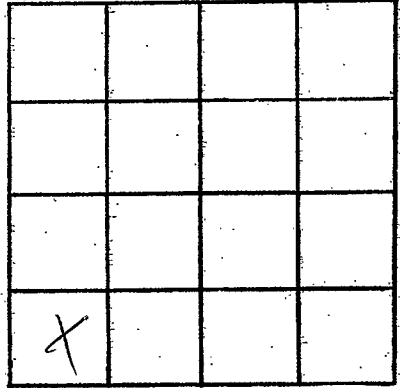

SECTION 27

Please indicate well location X.

ADDITIONAL INFORMATION

If more than one screen,  
show locations of each on sketch.