

Big Stream

MISSISSIPPI  
BOARD OF WATER COMMISSIONERS  
416 North State Street  
Jackson, Mississippi 39201

PANOLA  
R 70  
12-29-74

WATER WELL DRILLERS LOG

CODED


Dec 28 1974  
date well completed

J. B. Cain  
firm name

Panola  
county well located


LANDOWNER: <u>Martha Ware</u>	description of formations encountered	from	to
<u>Batesville Miss</u> (mailing address)			
<b>WELL LOCATION:</b>			
sec. <u>34</u> T. <u>28</u> N. R. <u>3</u> E. <u>7</u> W. <u>9</u> S.			
<u>3</u> miles <u>South</u> of <u>Batesville</u> (distance) (direction) (nearest town)			
<b>WELL PURPOSE:</b> <u>Home</u> (home, irrigation, municipal, industrial)			
<b>WELL COMPLETION DATA:</b>			
(1) diameter (inches) <u>4"</u>			
(2) total depth (feet) <u>140'</u>			
(3) static water level (feet) <u>20</u> below top of ground.			
(4) casing <u>Plastic</u> , <u>140</u> (material) (depth)			
_____ If telescope see back. (size)			
(5) screen <u>10'</u> , <u>130</u> (length) (depth to top)			
<u>4"</u> , <u>Plastic</u> (size) (material)			
(6) pump <u>3/4</u> , <u>10 gal</u> (HP) (yield gpm)			
<u>Elect</u> (type power)			
(7) electric log <u>No</u> (yes or no)			
_____ (organization running log)			
(8) how well bottom plugged <u>Plug</u>			
DRILLERS REMARKS:			
JAN. 23 1975			
MISS. Bd. of Water Comm.			

CODED

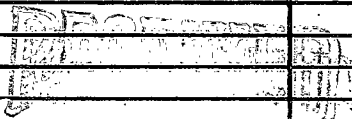

If well telescopes please sketch and show depths.

GROUND LEVEL

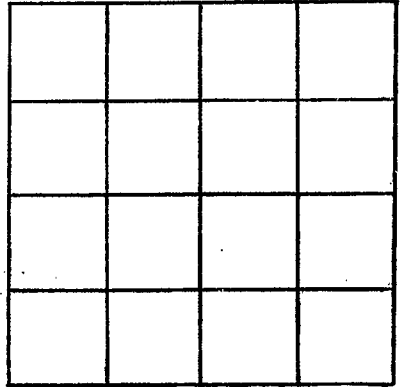

SECTION \_\_\_\_\_

Please indicate well location X.

ADDITIONAL INFORMATION

If more than one screen, show locations of each on sketch.