

Panola  
R 71  
8-18-75

MISSISSIPPI  
 BOARD OF WATER COMMISSIONERS  
 416 North State Street  
 Jackson, Mississippi 39201

WATER WELL DRILLERS LOG

CODED  
 PANOLA

8-18 1975 Lipe well co. Panola  
 date well completed firm name county well located

LANDOWNER:	description of formations encountered	from	to
<u>Cyrus Trantham</u>	<u>Topsoil</u>	<u>0</u>	<u>20</u>
<u>Batesville Miss.</u>	<u>sand</u>	<u>20</u>	<u>40</u>
(mailing address)	<u>clay</u>	<u>40</u>	<u>60</u>
WELL LOCATION:	<u>sand</u>	<u>60</u>	<u>80</u>
sec <u>23</u> T <u>9</u> N R <u>7</u> E <u>15F</u>	<u>clay</u>	<u>80</u>	<u>100</u>
<u>4</u> miles <u>S.E.</u> of <u>Batesville</u>	<u>clay</u>	<u>100</u>	<u>120</u>
(distance) (direction) (nearest town)	<u>clay</u>	<u>120</u>	<u>140</u>
	<u>sand and clay</u>	<u>140</u>	<u>160</u>
	<u>white sand</u>	<u>160</u>	<u>175</u>

WELL PURPOSE:  
 (home) irrigation, municipal, industrial

- WELL COMPLETION DATA:
- (1) diameter (inches) 4
  - (2) total depth (feet) 175
  - (3) static water level (feet) 60 below above top of ground.
  - (4) casing PVC 165  
 (material) (depth)
  - 4 if telescope see back.  
 (size)
  - (5) screen 10 165  
 (length) (depth to top)
  - 4 PVC  
 (size) (material)
  - (6) pump 3/4 10  
 (HP) (yield gpm)
  - elec.  
 (type power)
  - (7) electric log no  
 (yes or no)
  - no  
 (organization running log)
  - (8) how well bottom plugged PVC  
plug

CODED


RECEIVED  
 SEP - 1 1975

DRILLERS REMARKS:

MISSISSIPPI WATER

If well telescopes please sketch and show depths.

GROUND LEVEL

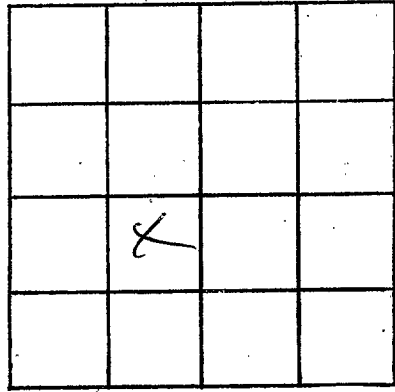

SECTION 23

Please indicate well location X.

ADDITIONAL INFORMATION

If more than one screen,  
show locations of each on sketch.