

PANOLA
R 75
12-20-78

MISSISSIPPI
BOARD OF WATER COMMISSIONERS
416 North State Street
Jackson, Mississippi 39201

CODED

WATER WELL DRILLERS LOG

12-20 1978 Lipe Well Co. Panola
date well completed firm name county well located

LANDOWNER:	description of formations encountered	from	to
Ken Bloodworth Batesville MS. (mailing address)			
WELL LOCATION: sec. 18 T ²⁵ N R ⁷ E 1 miles West of Batesville (distance) (direction) (nearest town)			
WELL PURPOSE: Agriculture Irrigation (municipal) Industrial			
WELL COMPLETION DATA:			
(1) diameter (inches) 6			
(2) total depth (feet) 90			
(3) static water level (feet) 15 below top of ground.			
(4) casing PVC 70 (material) (depth) 6 If telescope see back. (size)			
(5) screen 20 70 (length) (depth to top) 6 PVC (size) (material)			
(6) pump 5 150 (HP) (yield gpm) elec. (type power)			
(7) electric log No (yes or no) No (organization running log)			
(8) how well bottom plugged PVC CAP			
DRILLERS REMARKS:			

CODED


RECEIVED
JAN 10 1978

JAN 10 1978

MISSISSIPPI BOARD OF WATER COMMISSIONERS

If well telescopes please sketch and show depths.

GROUND LEVEL

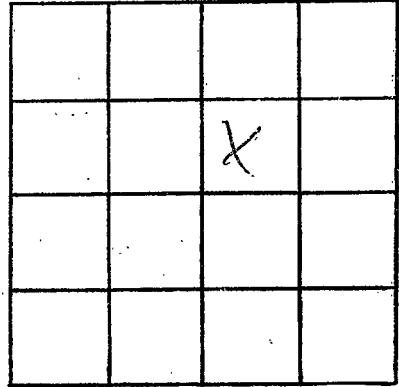

SECTION 18

Please indicate well location X.

ADDITIONAL INFORMATION

If more than one screen, show locations of each on sketch.