

PANOLA

R-76

5/1/80

541

date well completed

MISSISSIPPI
 BOARD OF WATER COMMISSIONERS CODED
 416 North State Street
 Jackson, Mississippi 39201

WATER WELL DRILLERS LOG

1980 Lipe Well Co.

Panola

firm name

county well located

LANDOWNER:

Kelley Mahan
 Batesville Ms.
 (mailing address)

description of formations encountered

TOP SOIL
 red sand
 gravel
 ..
 pea GRADED
 ..
 white sand

from to

0 20
 20 40
 40 60
 60 80
 80 100
 100 120
 120 136

WELL LOCATION:

sec. 16 T 9 N R 2 E
 S 3 E 4
 1/4 miles S.E. of Batesville
 (distance) (direction) (nearest town)

WELL PURPOSE:

(home, irrigation, municipal, industrial)

WELL COMPLETION DATA:

- (1) diameter (inches) 4
- (2) total depth (feet) 136
- (3) static water level (feet) 63 below top of ground.
- (4) casing PVC 124 (material) (depth)
 4 (size) if telescope see back.
- (5) screen 12 124 (length) (depth to top)
 4 PVC (size) (material)
- (6) pump 1 1/2 30 (HP) (yield gpm)
 elec. (type power)
- (7) electric log no (yes or no)
 non (organization running log)
- (8) how well bottom plugged PVC cap

DEPT. OF NATURAL RESOURCES
 BUREAU OF LAND & WATER RESOURCES


MAY 19 1980

RECEIVED

DRILLERS REMARKS:

If well telescopes please sketch and show depths.

GROUND LEVEL

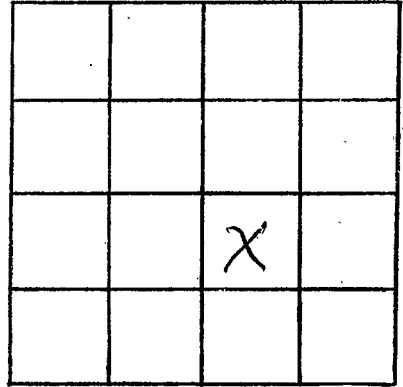

SECTION 16

Please indicate well location X.

ADDITIONAL INFORMATION

If more than one screen,
show locations of each on sketch.