

PANOLA

R-77

MISSISSIPPI
 BOARD OF WATER COMMISSIONERS CODED
 416 North State Street
 Jackson, Mississippi 39201

WATER WELL DRILLERS LOG

4/28/80

4-28

1980 LIPE Well Co. Panola

date well completed

firm name

county well located

LANDOWNER:

Kelly Mahan

Batesville, MS
(mailing address)

WELL LOCATION:

sec. 16 T 9 N R 7 E
 S W
 1/4 miles S. E. of Batesville
 (distance) (direction) (nearest town)

WELL PURPOSE:

(home, irrigation, municipal, industrial)

WELL COMPLETION DATA:

- (1) diameter (inches) 4
- (2) total depth (feet) 163
- (3) static water level (feet) 63 below top of ground.
- (4) casing PVC 151 (material) (depth)
4 (size) if telescope see back.
- (5) screen 12 151 (length) (depth to top)
4 PVC (size) (material)
- (6) pump 1/2 30 (HP) (yield gpm)
elec. (type power)
- (7) electric log no (yes or no)
NON (organization running log)
- (8) how well bottom plugged PVC
C 2P

description of formations encountered

from to

Top Soil	0	20
red sand	20	40
gravel	40	60
"	60	80
pea gravel	80	100
" "	100	120
white sand	120	163

CODED

DEPT. OF NATURAL RESOURCES
BUREAU OF LAND & WATER RESOURCES


MAY 19 1980

RECEIVED

DRILLERS REMARKS:

If well telescopes please sketch and show depths.

GROUND LEVEL

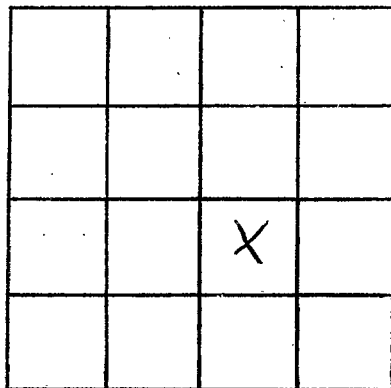

SECTION 16

Please indicate well location X.

ADDITIONAL INFORMATION

If more than one screen,
show locations of each on sketch.