

R 80
 PANOLA Co.
 5-29-84

MISSISSIPPI
 BOARD OF WATER COMMISSIONERS
 416 North State Street
 Jackson, Mississippi 39201

CODED

WATER WELL DRILLERS LOG

May 29 1984 Lipell Well Supply Panola
 date well completed firm name county well located


LANDOWNER: <u>Ch. Mah. etc. etc.</u>	description of formations encountered	from	to
<u>Batesville MS.</u>	<u>Topsoil - Clear</u>	<u>0</u>	<u>0.0</u>
(mailing address)	<u>Sand & gravel</u>	<u>2.0</u>	<u>6.0</u>
WELL LOCATION:	<u>clay</u>	<u>8.0</u>	<u>9.0</u>
sec. <u>8</u> T. <u>9</u> N R. <u>2</u> (E) <u>7W</u>	<u>SAND</u>	<u>9.0</u>	<u>16.0</u>
<u>IN</u> miles <u>Center</u> of <u>Batesville</u>			
(distance) (direction) (nearest town)			
WELL PURPOSE: (home, irrigation, municipal, industrial)			
WELL COMPLETION DATA:			
(1) diameter (inches) <u>4</u>			
(2) total depth (feet) <u>160</u>			
(3) static water level (feet) <u>10</u> <u>below</u> above top of ground.			
(4) casing <u>PVC</u> , <u>140</u> (material) (depth)			
<u>4"</u> (size) if telescope see back.			
(5) screen <u>20</u> , <u>140</u> (length) (depth to top)			
<u>13</u> , <u>PVC</u> (size) (material)			
(6) pump <u>2</u> , <u>35</u> (HP) (yield gpm)			
<u>elec</u> (type power)			
(7) electric log <u>No</u> (yes or no)			
(organization running log)			
(8) how well bottom plugged <u>PVC</u> <u>cap</u>			
DRILLERS REMARKS:			

DEPT. OF NATURAL RESOURCES
 BUREAU OF LAND & WATER RESOURCES

JUN 17 1984
 RECEIVED

If well telescopes please sketch and show depths.

GROUND LEVEL

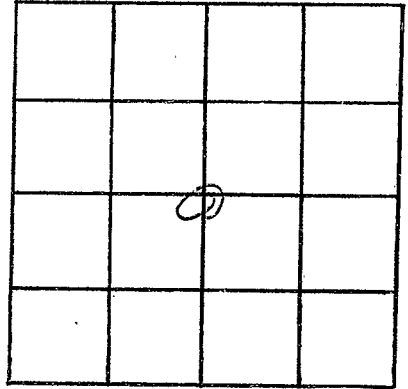

SECTION _____

Please indicate well location X.

ADDITIONAL INFORMATION

If more than one screen,
show locations of each on sketch.