

R81

PANOLA CO.

5-30-84

MISSISSIPPI
 BOARD OF WATER COMMISSIONERS
 416 North State Street
 Jackson, Mississippi 39201

CODED

WATER WELL DRILLERS LOG

May 30
date well completed

1984 Lipe Well & Supply
firm name

Panola
county well located

LANDOWNER: Church of Christ
 Batesville MS
 (mailing address)

| description of formations encountered | from | to |
|---------------------------------------|------|----|
| clay | 0 | 20 |
| sand & gravel | 20 | 30 |

WELL LOCATION:
 sec. 2 T. 9 N R. 2 E TW
 IN miles direction (nearest town)
 (distance) (direction) (nearest town)

WELL PURPOSE:
 (home, irrigation, municipal, industrial)

- WELL COMPLETION DATA:
- (1) diameter (inches) 4
 - (2) total depth (feet) 74
 - (3) static water level (feet) 10 ^{below} / _{above} top of ground.
 - (4) casing PVC, 64 (material), (depth)
 2 1/2 (size) if telescope see back.
 - (5) screen 10 (length), 64 (depth to top)
 2 1/2 (size), PVC (material)
 - (6) pump None (HP), (yield gpm)
 (type power)
 - (7) electric log No (yess or no)
 (organization running log)
 - (8) how well bottom plugged PVC
 cap


DRILLERS REMARKS:

DEPT. OF NATURAL RESOURCES
 BUREAU OF LAND & WATER RESOURCES

JUN 11 1984
 RECEIVED

If well telescopes please sketch and show depths.

GROUND LEVEL

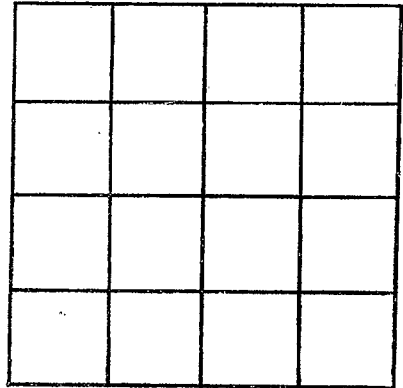

SECTION _____

Please indicate well location X.

ADDITIONAL INFORMATION

If more than one screen,
show locations of each on sketch.