

Panola
R91

MISSISSIPPI
BOARD OF WATER COMMISSIONERS
416 North State Street
Jackson, Mississippi 39201

P. 2


WATER WELL DRILLERS LOG

1/13 19 92 LIPE Cont'd PANOLA
date well completed firm name county well located

LANDOWNER:	description of formations encountered	from	to
Pope Courtland Water Pope, MS 38658 (mailing address)	1165-1185 brtll clay		
WELL LOCATION: sec. 33 T 20 N R 3 E S W 1 miles N of Courtland (distance) (direction) (nearest town)	brtll clay	1185	1205
WELL PURPOSE: <u>Just</u> (home, irrigation, municipal, industrial)	brtll clay w/ little sand	1205	1225
WELL COMPLETION DATA:	" " then sand streak	1225	1245
(1) diameter (inches)	sand w/ clay, then clay	1245	1265
(2) total depth (feet) <u>1365'</u>	clay	1265	1285
(3) static water level (feet) _____ below above top of ground.	clay w/ little sand	1285	1305
(4) casing (material) (depth) _____ _____ if telescope see back. (size)	" "	1305	1325
(5) screen (length) (depth to top) _____ (size) (material)	" "	1325	1345
(6) pump (HP) (yield gpm) _____ (type power)	clay	1345	1365
(7) electric log (yes or no) _____ (organization running log)			
(8) how well bottom plugged _____			
DRILLERS REMARKS:			

If well telescopes please sketch and show depths.

GROUND LEVEL

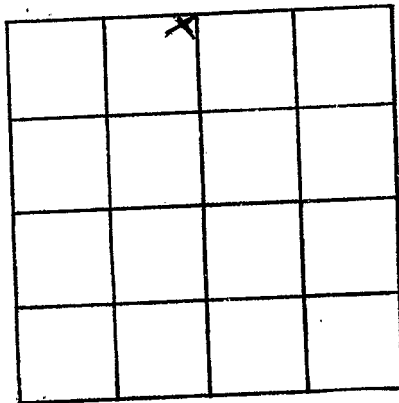

SECTION 33

Please indicate well location X.

ADDITIONAL INFORMATION

If more than one screen, show locations of each on sketch.