


If well telescopes please sketch and show depths.

GROUND LEVEL

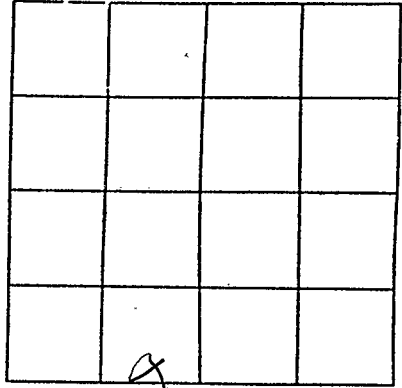

SECTION 20

Please indicate well location X.

| Pump Capacity (GPM) | No. of Stages | Setting Depth |
|---------------------|---------------|---------------|
| 12 | 12 | 150 FT. |

PUMP TEST

Well yielded 15 + GPM with
a drawdown of 4 ft.
after 4 hours of pumping

LOG DATA

TYPE OF LOG RUN (Circle One): No Log Run
Electric, Gamma Ray, Density, Sonic, Neutron,
Other (Describe) _____

Name of Organization Running Log

GEOLOGIC DATA (Office Use Only)

| Surface Elev. | Geologic Unit | Unit Thickness | Depth to Top |
|---------------|---------------|----------------|--------------|
| Subs. SWL | Date | Analysis | Aquifer Test |

Driller's Remarks

If more than one screen,
show location of each on sketch.