

R 1001  
7-26-65

WATER WELL DRILLERS LOG

Date: July 26, 1965, Driller: Layne-Central Co. County Panola  
(Name)

(1) Owner of Land: Federal Compress & Whse.  
(Name)  
Batesville, Miss.  
(Address)

(2) Location: 1/4, 1/4, Sec. T R  
miles of  
(distance) (direction) (Nearest Town)

(3) Topography: (Hilly) (Flat) (Level)

(4) Purpose of Well: Industrial  
(Domestic Irrigation  
Municipal, Industrial, Other)

Description & Color of Materials Sand, Clay, Red Clay, Shell, etc.	Thick- ness Feet	Depth Feet
sandy clay	34	34
sand stks clay	21	55
sand-small gravel	31	86
clay	2	88
white sand-stks clay	60	148
sandy clay	162	365
sandy clay	6	371
h.p. sand	17	388
h.p. sand	22	410
clay	3	413

Information upon completion of well:

(1) Diameter 10 inches.

(2) Total Depth 414' 6" feet.  
flowed 35 GPM at ground level

(3) Water Level 11' above feet below top of ground.


(4) Cased to 21' 9", Size 10"

(5) Screen: Size 8", Length 32'

(6) Were any formations sealed against pollution?  
X yes, no.

If YES depth of formation 21' 9"  
Why required

Drillers Remarks:

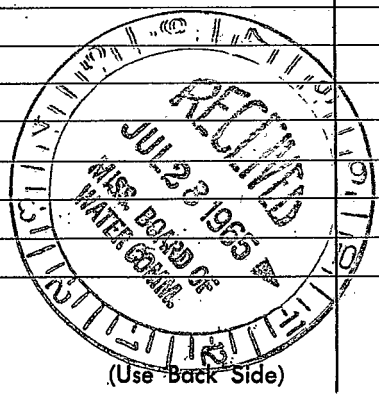

(Use Back Side)

Well No.

