

Panola
R 2000
10-1-75

MISSISSIPPI
 BOARD OF WATER COMMISSIONERS
 416 North State Street
 Jackson, Mississippi 39201

WATER WELL DRILLERS LOG

Oct. 1 1975 Lipe Well Cor Panola
 date well completed firm name county well located

LANDOWNER:
Woodie Loden
Batesville Miss,
 (mailing address)

description of formations encountered	from	to
<u>Top Soil</u>	<u>0</u>	<u>20</u>
<u>red sand</u>	<u>20</u>	<u>40</u>
<u>Gravel</u>	<u>40</u>	<u>60</u>
<u>Clay</u>	<u>60</u>	<u>80</u>
<u>sand</u>	<u>80</u>	<u>100</u>
<u>"</u>	<u>100</u>	<u>120</u>
<u>"</u>	<u>120</u>	<u>140</u>
<u>"</u>	<u>140</u>	<u>153</u>

WELL LOCATION:
 sec. 3 T. 19 N. R. 7 E. 15F
1 1/2 miles east of Batesville
 (distance) (direction) (nearest town)

WELL PURPOSE:
 (home) irrigation, municipal, industrial)

WELL COMPLETION DATA:

(1) diameter (inches) 4"

(2) total depth (feet) 153

(3) static water level (feet) 90 below above top of ground.

(4) casing PVC, 143
 (material) (depth)

4 If telescope see back.
 (size)

(5) screen 10, 143
 (length) (depth to top)

4, PVC
 (size) (material)


(6) pump 1, 15
 (HP) (yield gpm)

elec.
 (type power)

(7) electric log no
 (yes or no)

NOI
 (organization running log)

(8) how well bottom plugged PVC
plug

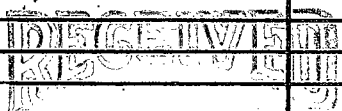


OCT 30 1975

DRILLERS REMARKS:

If well telescopes please sketch and show depths.

GROUND LEVEL

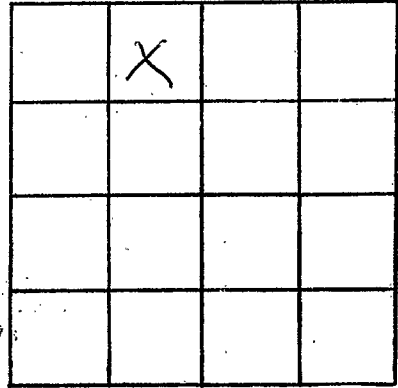

SECTION 3

Please indicate well location X.

ADDITIONAL INFORMATION

If more than one screen,
show locations of each on sketch.