

Panola  
R 2001  
12-1-75

MISSISSIPPI  
 BOARD OF WATER COMMISSIONERS  
 416 North State Street  
 Jackson, Mississippi 39201

WATER WELL DRILLERS LOG

12-1-1975 <sup>W.A. Mason</sup> Water Well Contractor Panola  
 date well completed firm name county well located

LANDOWNER:

Les A. Brassell  
PFD - Batesville Miss.  
 (mailing address)

description of formations encountered

	from	to
<u>Clay</u> <u>1st</u>	<u>0</u>	<u>15</u>
<u>Red sand</u>	<u>15</u>	<u>28</u>
<u>gravel</u>	<u>28</u>	<u>67</u>
<u>White sand</u>	<u>67</u>	<u>158</u>

WELL LOCATION:

sec 25 T 9 N R 7 E  
2 1/2 miles SE of Batesville  
 (distance) (direction) (nearest town)

WELL PURPOSE: Home  
 (home, irrigation, municipal, industrial)

WELL COMPLETION DATA:

- (1) diameter (inches) 4"
- (2) total depth (feet) 158'
- (3) static water level (feet) 96' below top of ground.
- (4) casing Plastic, 146'  
 (material) (depth)  
4" If telescope see back.  
 (size)
- (5) screen 10', 146'  
 (length) (depth to top)  
4" Plastic  
 (size) (material)
- (6) pump 1/2, 10  
 (HP) (yield gpm)  
Electric  
 (type power)
- (7) electric log No  
 (yes or no)  
 (organization running log)
- (8) how well bottom plugged Cap

DRILLERS REMARKS:

RECEIVED


FEB 17 1976

RD. OF WATER COMMISSIONERS

If well telescopes please sketch and show depths.

GROUND LEVEL

Large empty rectangular area for sketching well telescopes and depths.

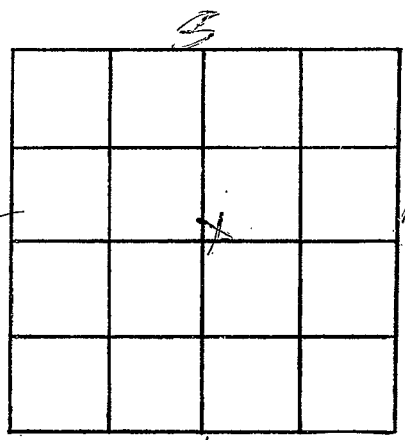

SECTION 25

Please indicate well location X.

ADDITIONAL INFORMATION

Lined area for additional information.

If more than one screen, show locations of each on sketch.