

Panola  
R 2002  
12-8-75

MISSISSIPPI  
 BOARD OF WATER COMMISSIONERS  
 416 North State Street  
 Jackson, Mississippi 39201

WATER WELL DRILLERS LOG

12-8 <sup>15F</sup> 1975 Lime Well Co Panola  
 date well completed firm name county well located

LANDOWNER:  
Dean Cook  
Courtland Miss,  
 (mailing address)


WELL LOCATION:  
 sec 27 T 9 N R 2 E  
 (S) (W)  
2 miles north of Courtland  
 (distance) (direction) (nearest town)

WELL PURPOSE:  
 (home) Irrigation, municipal, industrial

- WELL COMPLETION DATA:
- (1) diameter (inches) 4
  - (2) total depth (feet) 142
  - (3) static water level (feet) 80 below above top of ground.
  - (4) casing PVC, 132,  
 (material) (depth)  
4 if telescope see back.  
 (size)
  - (5) screen 10, 132  
 (length) (depth to top)  
4, PVC  
 (size) (material)
  - (6) pump 3/4, 10  
 (HP) (yield gpm)  
elec.  
 (type power)
  - (7) electric log no  
 (yes or no)  
no  
 (organization running log)
  - (8) how well bottom plugged PVC  
plug

description of formations encountered	from	to
<u>TOP soil</u>	<u>0</u>	<u>20</u>
<u>red sand</u>	<u>20</u>	<u>40</u>
<u>cc cc</u>	<u>40</u>	<u>60</u>
<u>Gravel</u>	<u>60</u>	<u>80</u>
<u>ls</u>	<u>80</u>	<u>100</u>
<u>sand</u>	<u>100</u>	<u>120</u>
<u>sand</u>	<u>120</u>	<u>142</u>

DRILLERS REMARKS:

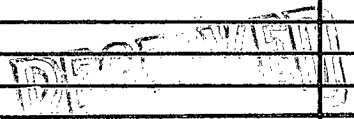


DEC 22 1975

MISS. BD. OF WATER COMMISSIONERS

If well telescopes please sketch and show depths.

GROUND LEVEL

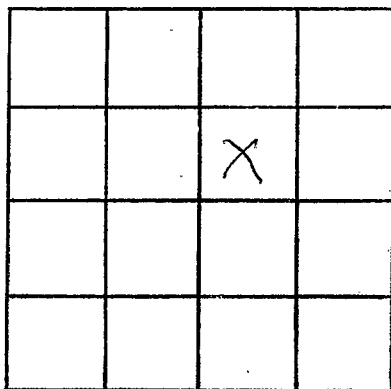

SECTION 27

Please indicate well location X.

ADDITIONAL INFORMATION

If more than one screen,  
show locations of each on sketch.