

Panola

~~Panola~~  
R 2005  
2/16/78

MISSISSIPPI  
BOARD OF WATER COMMISSIONERS  
416 North State Street  
Jackson, Mississippi 39201

WATER WELL DRILLERS LOG

2-16-1978 date well completed      Lipe Well Co. firm name      Panola county well located

LANDOWNER:  
Willie Odum  
Batesville  
(mailing address)

description of formations encountered	from	to
Top Soil	0	20
Gravel	20	30
Sand	30	70

WELL LOCATION:  
sec. 5 T. 9 N R. 7 W  
1 1/2 miles North of Batesville  
(distance) (direction) (nearest town)

WELL PURPOSE:  
(home, irrigation, municipal, industrial)

- WELL COMPLETION DATA:
- (1) diameter (inches) 4
  - (2) total depth (feet) \_\_\_\_\_
  - (3) static water level (feet) 5' below above top of ground.
  - (4) casing PVC 70 (material) (depth)
  - 4 (size) if telescope see back.
  - (5) screen 10 60 (length) (depth to top)
  - 4 PVC (size) (material)
  - (6) pump 3/4 10 (HP) (yield gpm)
  - elec. (type power)
  - (7) electric log NON (yes or no)
  - NON (organization running log)
  - (8) how well bottom plugged PVC Plug


DRILLERS REMARKS:

RECEIVED  
MAR 29 1978

MISS. BD. OF WATER COMMISSIONERS

If well telescopes please sketch and show depths.

GROUND LEVEL

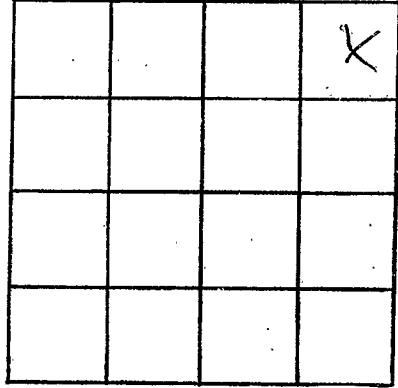

SECTION 3

Please indicate well location X.

ADDITIONAL INFORMATION

Lined area for additional information.

If more than one screen, show locations of each on sketch.