

PANOLA  
 R 2006  
 4-27-78

MISSISSIPPI  
 BOARD OF WATER COMMISSIONERS  
 416 North State Street  
 Jackson, Mississippi 39201

WATER WELL DRILLERS LOG

4-27 1978 Life Well Co. Panola  
 date well completed firm name county well located

LANDOWNER:  
John Egbert  
Batesville MS.  
 (mailing address)

WELL LOCATION:  
 sec. 21 T 9 N R 3 E  
1 miles East of Batesville  
 (distance) (direction) (nearest town)

WELL PURPOSE:  
 (home) irrigation, municipal, industrial

WELL COMPLETION DATA:

(1) diameter (inches) 4

(2) total depth (feet) 167

(3) static water level (feet) 90 below above top of ground.

(4) casing PVC 157  
 (material) (depth)  
4 if telescope see back.  
 (size)

(5) screen 10 157  
 (length) (depth to top)  
4 PVC  
 (size) (material)

(6) pump 3/4 10  
 (HP) (yield gpm)  
elec.  
 (type power)

(7) electric log no  
 (yes or no)  
no  
 (organization running log)

(8) how well bottom plugged PVC  
C&P

description of formations encountered	from	to
Top Soil	0	20
Sand	20	40
Gravel	40	90
Sand	90	100
Clay	100	110
White Clay and Sand	110	120
sand	120	140
ll	140	167

RECEIVED


MAY 8 - 1978

DRILLERS REMARKS:

MISS. BD. OF WATER COMM.

If well telescopes please sketch and show depths.

GROUND LEVEL

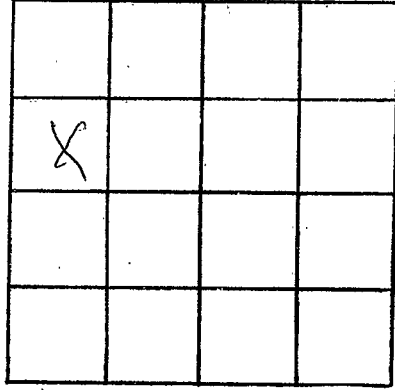

SECTION 21

Please indicate well location X.

ADDITIONAL INFORMATION

Lined area for additional information, consisting of approximately 18 horizontal lines.

If more than one screen, show locations of each on sketch.