

PANOLA
R 2007
7-2-79

MISSISSIPPI
BOARD OF WATER COMMISSIONERS
416 North State Street
Jackson, Mississippi 39201

WATER WELL DRILLERS LOG

7-2-79 date well completed 1979 North Miss Well Drilling Panola firm name Panola county well located

LANDOWNER: Doyle Ridge country	description of formations encountered	from	to
	Clay	0	30
(mailing address)	Gravel	30	115

WELL LOCATION: 9 7
sec 32 T 28 N R 3 E
4 miles S of Batesville
(distance) (direction) (nearest town)

WELL PURPOSE: Home
(home, irrigation, municipal, industrial)

- WELL COMPLETION DATA:
- (1) diameter (inches) ~~4"~~ 4"
 - (2) total depth (feet) 140
 - (3) static water level (feet) 120 below top of ground
 - (4) casing (material) Plastic, (depth) 130
 - (size) if telescope see back.
 - (5) screen 10' (length), 130 (depth to top)
 - 4" (size), Plastic (material)
 - (6) pump 1/2 (HP), 10 (yield gpm)
 - Elec (type power)
 - (7) electric log 70 (yes or no)

(organization running log)
(8) how well bottom plugged Wash Bot

DRILLERS REMARKS:


Miss. Board of Water Comm.

JUL 20 1979

RECEIVED

If well telescopes please sketch and show depths.

GROUND LEVEL

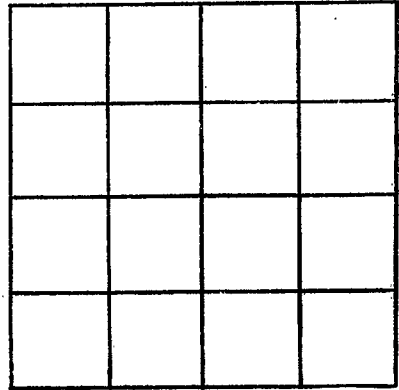

SECTION _____

Please indicate well location X.

ADDITIONAL INFORMATION

If more than one screen,
show locations of each on sketch.