

PANTOLA

MISSISSIPPI
BOARD OF WATER COMMISSIONERS
416 North State Street
Jackson, Mississippi 39201

WATER WELL DRILLERS LOG

R 2008

6-18-80

6-18
date well completed

19 80 North Miss Well Dril Pantola
firm name county well located

LANDOWNER

Bill Nickles

description of formations encountered

from to

(mailing address)

Clay
Gravel
Sand

0 8
8 100
100 155

WELL LOCATION:

sec 22 T 9 N R 7 E
SW NW
2 miles S-E of Batesville
(distance) (direction) (nearest town)

WELL PURPOSE:

Home
(home, irrigation, municipal, industrial)

WELL COMPLETION DATA:

- (1) diameter (inches) 4x2
- (2) total depth (feet) 135
- (3) static water level (feet) 115 below top of ground
- (4) casing Plastic, 155 (material) (depth)
4x2 If telescope see back. (size)
- (5) screen 10' 150 (length) (depth to top)
2 Plastic (size) (material)
- (6) pump 1/2 5 (HP) (yield gpm)
5 hp (type power)
- (7) electric log No (yes or no)

(organization running log)

(8) how well bottom plugged Cap

DRILLERS REMARKS:

Ruff Gravel

DEPT. OF NATURAL RESOURCES
BUREAU OF LAND & MINERAL RESOURCES

JUN 30 1980

RECEIVED


If well telescopes please sketch and show depths.

GROUND LEVEL



125'

30 Foot

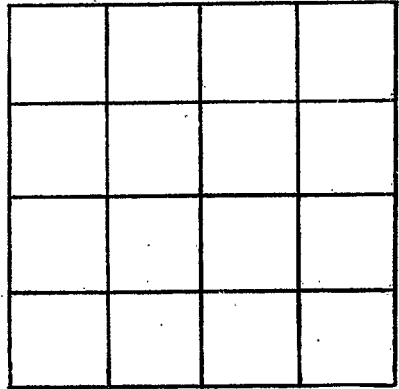

SECTION _____

Please indicate well location X.

ADDITIONAL INFORMATION

If more than one screen, show locations of each on sketch.