

PANDOLA

MISSISSIPPI
BOARD OF WATER COMMISSIONERS
416 North State Street
Jackson, Mississippi 39201

WATER WELL DRILLERS LOG

6-25-80
6-25-80
date well completed

1980 North Miss Well Drill Pandola
firm name. county well located

LANDOWNER: Chester Robinson

Batesville

(mailing address)

WELL LOCATION:

sec. 31 T. 28 N. R. 3 E. 4
4 miles S-W of Batesville
(distance) (direction) (nearest town)

WELL PURPOSE:

(home, irrigation, municipal, industrial)

WELL COMPLETION DATA:

- (1) diameter (inches) 4"
- (2) total depth (feet) 146
- (3) static water level (feet) 95 below top of ground.
- (4) casing Plastic (material) 146 (depth)

(size) if telescope see back.

- (5) screen 10' (length) 13 1/2 (depth to top)
- 4" (size) Plastic (material)

- (6) pump 3A (HP) 10 (yield gpm)

Elec (type power)

- (7) electric log No (yes or no)

(organization running log)

- (8) how well bottom plugged Work Bot

DRILLERS REMARKS:

description of formations encountered

from to

Clay 0 18

Gravel 18 80

Sand 80 90

Gravel 90 121

Sand 121 146


DEPT. OF NATURAL RESOURCES
BUREAU OF LAND & WATER RESOURCES

JUN 30 1980

RECEIVED

If well telescopes please
sketch and show depths.

GROUND LEVEL

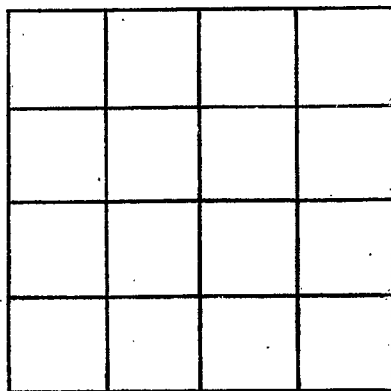

SECTION _____

Please indicate well location X.

ADDITIONAL INFORMATION

If more than one screen,
show locations of each on sketch.