

MISSISSIPPI DEPARTMENT OF NATURAL RESOURCES

Bureau of Land and Water Resources

Southport Mall

P.O. Box 10631

Jackson, Mississippi 39209

WATER WELL DRILLERS LOG

PANOLA
R 2010
1/181

1981 *Spring Wells Supply Co Inc Panola*
 date well completed 2/6/81 firm name _____ county well located _____

LANDOWNER: *Bob Maday*
Batesville, Ms.

description of formations encountered	from	to
CLAY	0	20
CLAY	20	40
GRAVEL	40	60
GRAVEL-SAND	60	80
CLAY	80	100
CLAY-SAND	100	120
CLAY	120	140
SAND	140	160
SAND	160	170

(mailing address)

WELL LOCATION:
 sec. 3 T. 9 N. R. 7 E.
 miles (distance) _____ (direction) _____ (nearest town) *Batesville*

WELL PURPOSE:
 (home, irrigation, municipal, industrial)

WELL COMPLETION DATA:

- (1) diameter (inches) 4
- (2) total depth (feet) 170 ft.
- (3) static water level (feet) 10 ft. above top of ground.
- (4) casing PVC (material), _____ (depth), _____ (size) if telescope see back.
- (5) screen 8 ft. (length), 162 (depth to top), 4 (size), _____ (material).
- (6) pump 3/4 (HP), 10 (yield gpm), _____ (type power).
- (7) electric log _____ (yes or no).
- _____ (organization running log)
- (8) how well bottom plugged Cap

DRILLERS REMARKS: _____


DEPT. OF NATURAL RESOURCES
 BUREAU OF LAND & WATER RESOURCES

MAY - 5 1981

RECEIVED

If well telescopes please sketch and show depths.

GROUND LEVEL

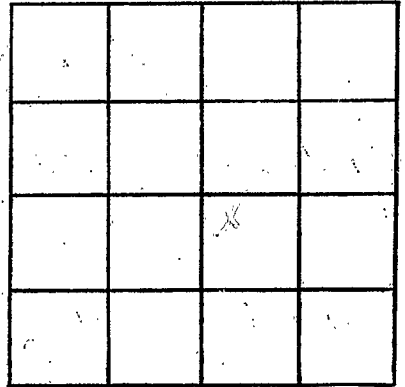

SECTION _____

Please indicate well location X.

ADDITIONAL INFORMATION

If more than one screen,
show locations of each on sketch.