

Janda  
R 2011

MISSISSIPPI  
 BOARD OF WATER COMMISSIONERS  
 416 North State Street  
 Jackson, Mississippi 39201

WATER WELL DRILLERS LOG

4/17/84 19 Lipe Well Supply Rowles  
 date well completed firm name county well located

LANDOWNER: Philip Smith  
Batesville Ms

description of formations encountered	from	to
<u>clay</u>	<u>0</u>	<u>20</u>
<u>sand &amp; gravel</u>	<u>20</u>	<u>80</u>
<u>sandy clay</u>	<u>80</u>	<u>150</u>
<u>sand</u>	<u>150</u>	<u>180</u>

(mailing address)

WELL LOCATION: 7  
 sec. 16 T. 9 N R. 2 E  
1 miles E of Batesville  
 (distance) (direction) (nearest town)

WELL PURPOSE:  
 (home) irrigation, municipal, industrial

WELL COMPLETION DATA:

- (1) diameter (inches) 4
- (2) total depth (feet) 180
- (3) static water level (feet) 114 <sup>below</sup> <sub>above</sub> top of ground.
- (4) casing PVC, 170,  
 (material) (depth)  
4 If telescope see back.  
 (size)
- (5) screen 10, 170  
 (length) (depth to top)  
4, PVC  
 (size) (material)
- (6) pump 1, 19  
 (HP) (yield gpm)  
dc  
 (type power)
- (7) electric log (yes of no) no

(organization running log)

(8) how well bottom plugged PVC  
cep

DRILLERS REMARKS:


MISSISSIPPI DEPARTMENT OF AGRICULTURE  
 BUREAU OF LAND & WATER RESOURCES

APR 23 1984

RECEIVED

If well telescopes please sketch and show depths.

GROUND LEVEL

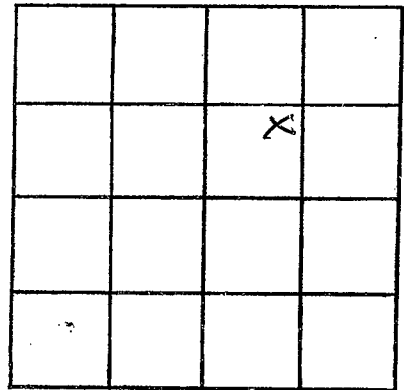

SECTION 16

Please indicate well location X.

ADDITIONAL INFORMATION

If more than one screen, show locations of each on sketch.