

MISSISSIPPI DEPARTMENT OF NATURAL RESOURCES

Bureau of Land and Water Resources

Southport Mall

P.O. Box 10631

Jackson, Mississippi 39209

WATER WELL DRILLERS LOG

ANOLA
R 2013

GW-414

7-15 1985 LIFE WELL & SUPPLY ANOLA
date well completed firm name county well located

LANDOWNER: MAC K TAYLOR
304 HWY 51 S
BATESVILLE, MS
(mailing address)

WELL LOCATION:
sec 26 T 9 N R 7 E
5 miles E of BATESVILLE
(distance) (direction) (nearest town)


WELL PURPOSE: HOME
(home, irrigation, municipal, industrial)

WELL COMPLETION DATA:

- (1) diameter (inches) 6"
- (2) total depth (feet) 155
- (3) static water level (feet) 90' below above top of ground.
- (4) casing PC 135
(material) (depth)
(size) if telescope see back.
- (5) screen 20 135
(length) (depth to top)
6 PC
(size) (material)
- (6) pump 2 20
(HP) (yield gpm)
230 10
(type power)
- (7) electric log NO
(yes or no)
(organization running log)
- (8) how well bottom plugged CAP

description of formations encountered	from	to
top soil	0	10
sandy pea gravel	10	20
gravel	20	40
clay	40	60
clay	60	80
clay	80	100
clay + sand	100	120
sand	120	140
sand	140	155


DRILLERS REMARKS:

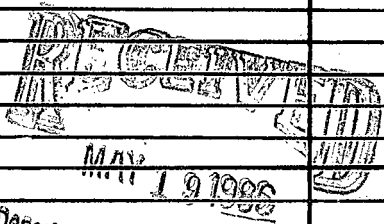

Department of Natural Resources
Bureau of Land and Water Resources

If well telescopes please sketch and show depths.

GROUND LEVEL

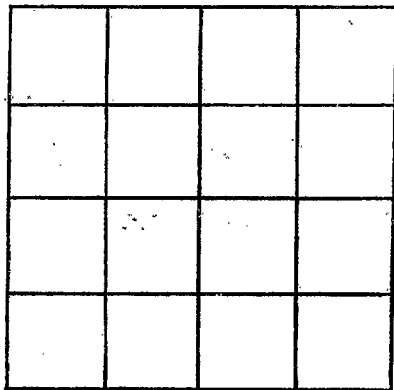

SECTION _____

Please indicate well location X.

ADDITIONAL INFORMATION

If more than one screen,
show locations of each on sketch.