

MISSISSIPPI DEPARTMENT OF NATURAL RESOURCES

Bureau of Land and Water Resources

Southport Mall

P.O. Box 10631

Jackson, Mississippi 39209

WATER WELL DRILLERS LOG

PANOLA  
R 2014

8-15 1985 LIFE WELL & SUPPLY PANOLA  
date well completed firm name county well located


LANDOWNER: DR. BILLY HAIRE  
HWY 6 EAST  
BATESVILLE, MS  
(mailing address)

WELL LOCATION:  
sec 16 T. 9 N. R. 7 E  
2 miles SE of BATESVILLE  
(distance) (direction) (nearest town)

WELL PURPOSE: HOME  
(home, irrigation, municipal, industrial)

- WELL COMPLETION DATA:
- (1) diameter (inches) 4"
  - (2) total depth (feet) 140
  - (3) static water level (feet) 60 below above top of ground.
  - (4) casing PVC, 130,  
(material) (depth)  
         If telescope see back.  
(size)
  - (5) screen 10', 130  
(length) (depth to top)  
4", PVC  
(size) (material)
  - (6) pump 1, 15  
(HP) (yield gpm)  
230V 1/2  
(type power)
  - (7) electric log NO  
(yes or no)  
          
(organization running log)
  - (8) how well bottom plugged CAP

description of formations encountered	from	to
top soil	0	5
pec gravel	5	20
clay + sand	20	40
scnel	40	60
silt + clay + sand	60	80
" " "	80	100
sand	100	120
sand	120	140

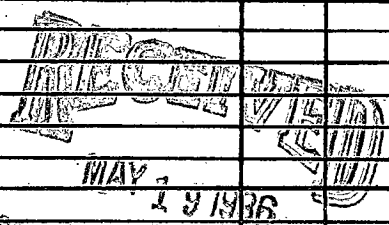


DRILLERS REMARKS:

Department of Natural Resources  
Bureau of Land and Water Resources

If well telescopes please sketch and show depths.

GROUND LEVEL

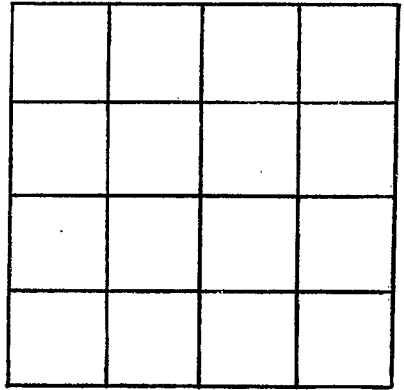

SECTION \_\_\_\_\_

Please indicate well location X.

ADDITIONAL INFORMATION

If more than one screen,  
show locations of each on sketch.