

MISSISSIPPI DEPARTMENT OF NATURAL RESOURCES

Bureau of Land and Water Resources

Southport Mall

P.O. Box 10631

Jackson, Mississippi 39209

WATER WELL DRILLERS LOG

Panola
R 2015

3-13-87
date well completed

LIFE WELL & SUPPLY PANOLA
firm name

county well located

LANDOWNER: MR. BILL COOK
DOGWOOD HILLS
BATESVILLE, MS
(mailing address)

WELL LOCATION:
sec. 15 T 9 S R. 7 E W
2 miles SE of BATESVILLE
(distance) (direction) (nearest town)

WELL PURPOSE: HEAT PUMP
(home, irrigation, municipal, industrial)

- WELL COMPLETION DATA:
- (1) diameter (inches) 4"
 - (2) total depth (feet) 160'
 - (3) static water level (feet) 103' below above top of ground.
 - (4) casing PVC, 150',
(material) (depth)
if telescope see back.
(size)
 - (5) screen 10', 150'
(length) (depth to top)
4, PVC-GRAVEL PACK
(size) (material)
 - (6) pump 3/4, 10
(HP) (yield gpm)
230 1/2
(type power)
 - (7) electric log NO
(yes or no)
(organization running log)
 - (8) how well bottom plugged EVOCAP

description of formations encountered	from	to
TOP SOIL	0	5
RED SAND & CLAY	5	20
RED SAND, PEA GRAVEL	20	40
PEA GRAVEL	40	60
PEA GRAVEL	60	70
CLAY W/SAND	70	80
CLAY W/SAND	80	90
SAND	90	100
SAND	100	120
SAND	120	140
SAND	140	160

RECEIVED


JAN 19 1988

Department of Natural Resources
Bureau of Land & Water

DRILLERS REMARKS:

If well telescopes please sketch and show depths.

GROUND LEVEL

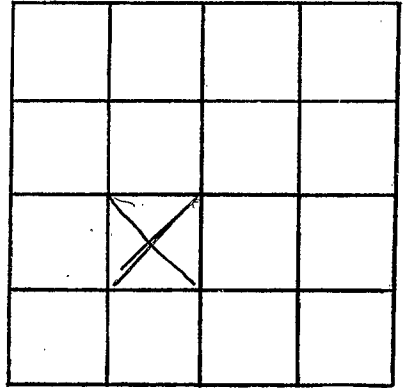

SECTION 15

Please indicate well location X.

ADDITIONAL INFORMATION

If more than one screen,
show locations of each on sketch.