

MISSISSIPPI DEPARTMENT OF NATURAL RESOURCES
Bureau of Land and Water Resources
 Southport Mall
 P.O. Box 10631
 Jackson, Mississippi 39209
WATER WELL DRILLERS LOG

PANOLA
R 2016

3-15 date well completed 87 LIPE WELL & SUPPLY firm name PANOLA county well located

LANDOWNER: MR. BILL COOK
DORWOOD HILLS
BATESVILLE, MS
 (mailing address)

WELL LOCATION:
 sec. 15 T 9 S R 7 E W
2 miles SE of BATESVILLE
 (distance) (direction) (nearest town)

WELL PURPOSE: HEAT PUMP
 (home, irrigation, municipal, industrial)

WELL COMPLETION DATA:

(1) diameter (inches) 4

(2) total depth (feet) 135

(3) static water level (feet) 103 below above top of ground.

(4) casing 4" (material) 125' (depth)

 if telescope see back.
 (size)

(5) screen 10' (length) 125' (depth to top)

4" PVC
 (size) (material)

(6) pump DISG. WELL (HP) (yield gpm)


 (type power)

(7) electric log NO (yes or no)

 (organization running log)

(8) how well bottom plugged PCCAP

| description of formations encountered | from | to |
|---------------------------------------|------|-----|
| TOP SOIL | 0 | 5 |
| RED SAND & CLAY | 5 | 20 |
| RED SAND & GRAVEL | 20 | 40 |
| PEA GRAVEL | 40 | 60 |
| PEA GRAVEL | 60 | 70 |
| CLAY W/ SAND | 70 | 80 |
| CLAY W/ SAND | 80 | 90 |
| SAND | 90 | 100 |
| SAND | 100 | 120 |
| SAND | 120 | 135 |

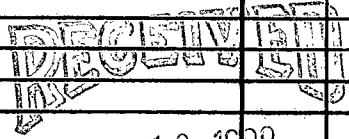


Department of Natural Resources
 Bureau of Land & Water Resources

DRILLERS REMARKS: _____

If well telescopes please sketch and show depths.

GROUND LEVEL

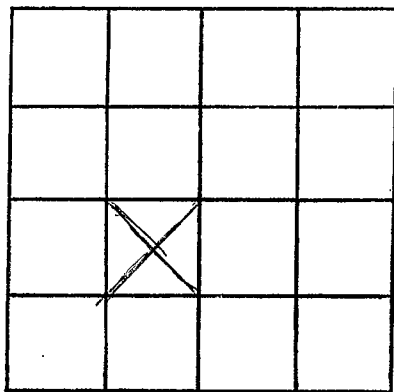

SECTION 15

Please indicate well location X.

ADDITIONAL INFORMATION

If more than one screen,
show locations of each on sketch.