

PANOLA
S

WATER WELL DRILLERS LOG

Date: 7-20-62, Driller: J B CAIN County PANOLA

(Name)

(1) Owner of Land: RAY D MEAK
(Name)

COURTLAND MISS
(Address)

(2) Location: 1/4, 1/4, Sec. 5 T R

8 miles E, of BATESVILLE
(distance) (direction) (Nearest Town)

(3) Topography: (Hilly) (Flat) (Level)

(4) Purpose of Well:
(Domestic Irrigation
Municipal, Industrial, Other)

Information upon completion of well:

(1) Diameter 2 inches.

(2) Total Depth 110 feet.

(3) Water Level 80 feet below top of ground.

(4) Cased to 110, Size 2"

(5) Screen: Size 1/4, Length 6 FT


(6) Were any formations sealed against pollution?
 yes, no.

If YES depth of formation

Why

Drillers Remarks:

Description & Color of Materials Sand, Clay, Red Clay, Shell, etc.	Thick- ness Feet	Depth Feet
<u>Bad Cl</u>	<u>0</u>	<u>40</u>
<u>sh</u>	<u>40</u>	<u>70</u>
<u>Bad Clay</u>	<u>90</u>	<u>90</u>
<u>water sand</u>	<u>90</u>	<u>100</u>

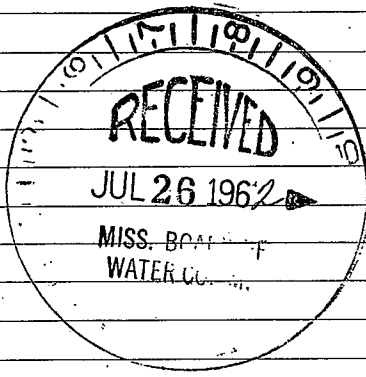

Well No.

(Use Back Side)

Retain this copy for your office files.

