

WATER WELL DRILLERS LOG

Date: 7-15, 1963, Driller: J B Cain County Panola
(Name)

(1) Owner of Land: J E Frankle
(Name)
Batesville miss
(Address)

Description & Color of Materials Sand, Clay, Red Clay, Shell, etc.	Thick- ness Feet	Depth Feet
<u>Brn Cl</u>	<u>0</u>	<u>30</u>
<u>Shale</u>	<u>30</u>	<u>55</u>
<u>Sand</u>	<u>55</u>	<u>85</u>

(2) Location: 1/4, 1/4, Sec. T R
10 miles East, of Batesville
(distance) (direction) (Nearest Town)

(3) Topography: (Hilly) (Flat) (Level)


(4) Purpose of Well: Home
(Domestic Irrigation
Municipal, Industrial, Other)

Information upon completion of well:

- (1) Diameter 2 inches.
- (2) Total Depth 85 feet.
- (3) Water Level 60 feet below top of ground.
- (4) Cased to 85, Size 2"
- (5) Screen: Size 3", Length 5
- (6) Were any formations sealed against pollution?
_____ yes, _____ no.

If YES depth of formation _____
Why _____

Drillers Remarks: this is a plastic well

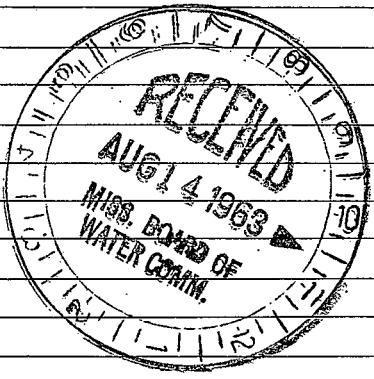

(Use Back Side)

Well No.

