

WATER WELL DRILLERS LOG

S
8-1-64

Date: 8-1, 164, Driller: J B Cain County Panola

(Name)

(1) Owner of Land Mrs Tidwell
(Name)
Batesville
(Address)

Description & Color of Materials Sand, Clay, Red-Clay, Shell, etc.	Thick- ness Feet	Depth Feet
<u>Brn Cl</u>	<u>0</u>	<u>20</u>
<u>Sp</u>	<u>20</u>	<u>40</u>
<u>Sand</u>	<u>40</u>	<u>65</u>

(2) Location: 1/4, 1/4, Sec. T R,
6 miles E, of Batesville
(distance) (direction) (Nearest Town)

(3) Topography: (Hilly) (Flat) (Level)

(4) Purpose of Well: Hand
(Domestic Irrigation
Municipal, Industrial, Other)


Information upon completion of well:

- (1) Diameter 2 1/2 inches.
- (2) Total Depth 65 feet.
- (3) Water Level 45 feet below top of ground.
- (4) Cased to 65, Size 2 1/2.
- (5) Screen: Size 1/4, Length 5.
- (6) Were any formations sealed against pollution?
_____ yes, _____ no.

If YES depth of formation _____

Why _____

Drillers Remarks: _____

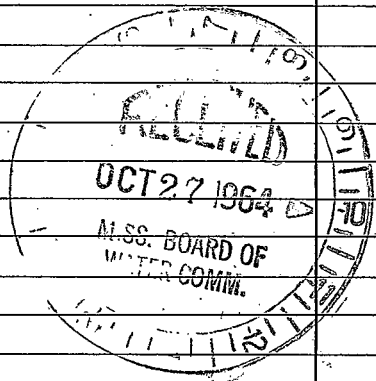

Well No.

(Use Back Side)

