

WATER WELL DRILLERS LOG

Date: 10-10-64 Driller: J.B. Cain County: Panola
 (Name)


(1) Owner of Land: R.H. Thomas
 (Name)
Stamps, Miss
 (Address)
 (2) Location: 1/4, 1/4, Sec. T R R
5 miles E of Stamps
 (distance) (direction) (Nearest Town)
 (3) Topography: _____
 (Hilly) (Flat) (Level)
 (4) Purpose of Well: _____
 (Domestic Irrigation, Municipal, Industrial, Other)

Description & Color of Materials Sand, Clay, Red Clay, Shell, etc.	Thick- ness Feet	Depth Feet
<u>Sand</u>	<u>0</u>	<u>10</u>
<u>Blue Clay</u>	<u>110</u>	<u>130</u>
<u>Sand</u>	<u>130</u>	<u>140</u>

Information upon completion of well:

(1) Diameter 2 inches.
 (2) Total Depth 138 feet.
 (3) Water Level 90 feet below top of ground.
 (4) Cased to 138 Size: 2"
 (5) Screen: Size 1/4" Length 5 FT
 (6) Were any formations sealed against pollution?
 _____ yes, _____ no.

If YES depth of formation _____
 Why _____
 Drillers Remarks: _____

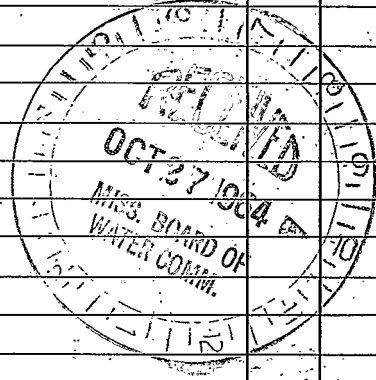

Well No.

(Use Back Side)

