

S  
11-9-64

WATER WELL DRILLERS LOG

Date: 11-9, 1964, Driller: J B Cairncastle County, Panola  
(Name)

	Description & Color of Materials Sand, Clay, Red Clay, Shell, etc.	Thick- ness Feet	Depth Feet
(1) Owner of Land: P J Anthony Cantland Miss (Name) (Address)	Brk of Sand + Gr Sand	0 25 60	25 60 78
(2) Location: 1/4, 1/4, Sec. T R 10 miles E of Batesville (distance) (direction) (Nearest Town)			
(3) Topography: <input checked="" type="checkbox"/> (Hilly) <input type="checkbox"/> (Flat) <input type="checkbox"/> (Level)			
(4) Purpose of Well: Home (Domestic Irrigation Municipal, Industrial, Other)			

Information upon completion of well:

(1) Diameter 2" inches.

(2) Total Depth 78 feet.


(3) Water Level 65 feet below top of ground.

(4) Cased to 78, Size 2"

(5) Screen: Size 1/4, Length 5 FT  
Screen Locked in

(6) Were any formations sealed against pollution?  
\_\_\_\_\_ yes, \_\_\_\_\_ no.

If YES depth of formation \_\_\_\_\_  
Why \_\_\_\_\_  
Drillers Remarks: \_\_\_\_\_

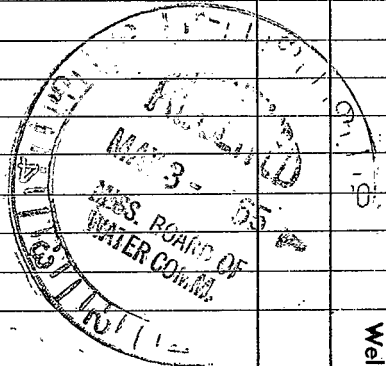

(Use Back Side)

Well No.

